


T.12S. R.8W.W.M.

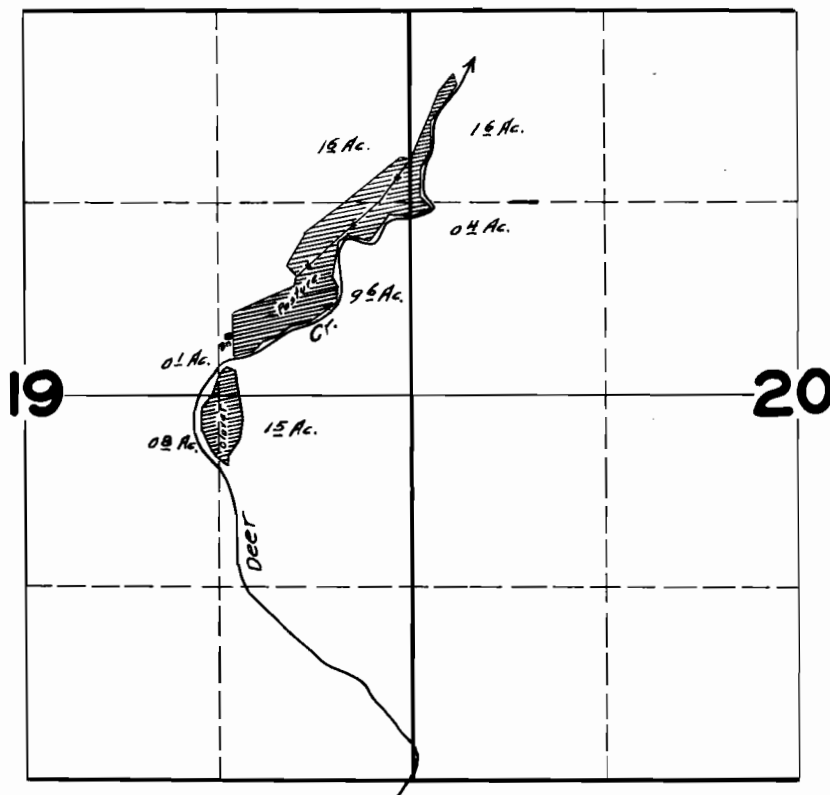

**FINAL PROOF SURVEY
UNDER**

Application No. 16204 Permit No. 12019

IN NAME OF

DELBERT R. KESSI

Surveyed AUG. 20 1945 by James S. Russell