


T.6S.R.10W.W.M.

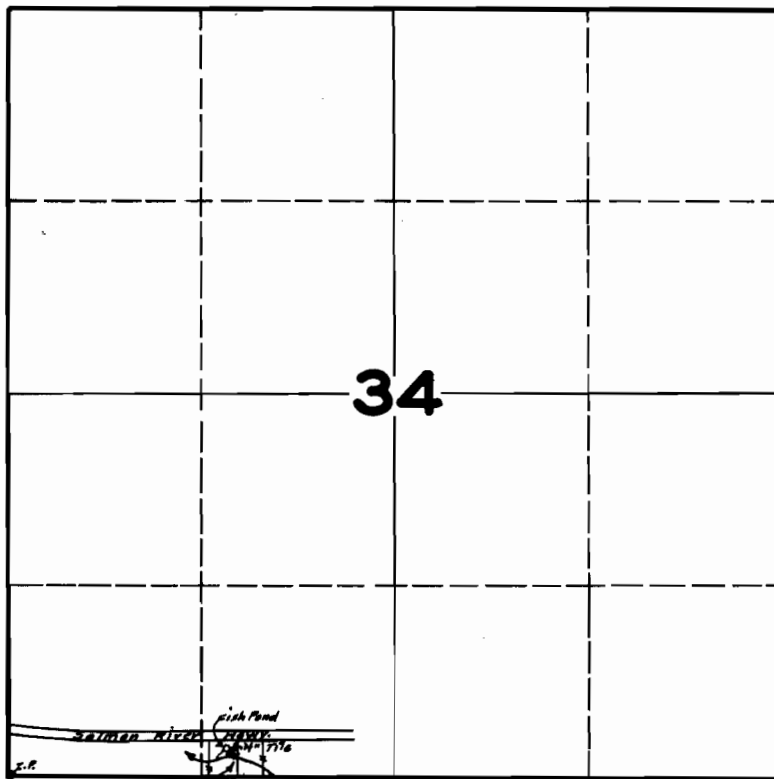


**FINAL PROOF SURVEY
UNDER**

Application No. 16300 Permit No. 12103

IN NAME OF
ARTHUR F. PETERSON

Surveyed JUNE 4, 1945, by [Signature]

T. 6 S., R. 10 W. W.M.

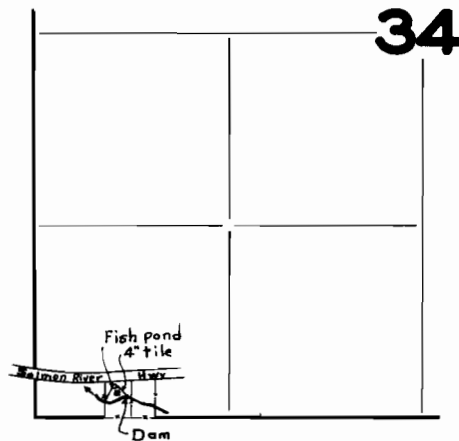

**FINAL PROOF SURVEY
UNDER**

Application No. 16300 Permit No. 12103

IN NAME OF

Arthur F. Peterson

Surveyed Sept. 8 1942, by Geoff Maderman