


T.10S. R.6W.W.M.

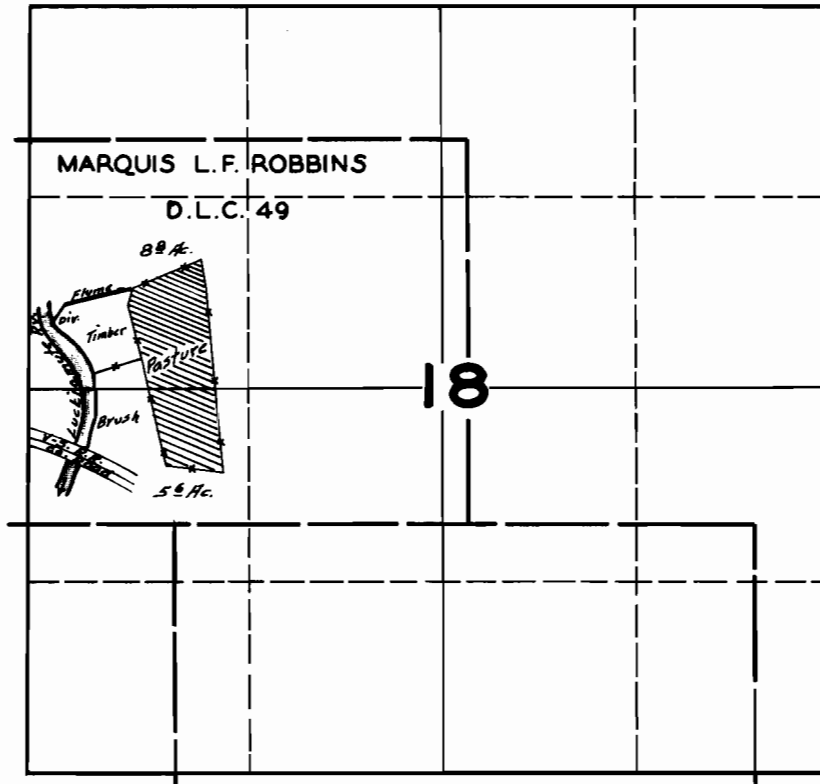

FINAL PROOF SURVEY UNDER

Application No. 16312 Permit No. 12122

IN NAME OF

MRS. W.S. ALCORN.

Surveyed JULY 24 1945, by

Frank J. Russell