


T.14S. R.4W. W.M.

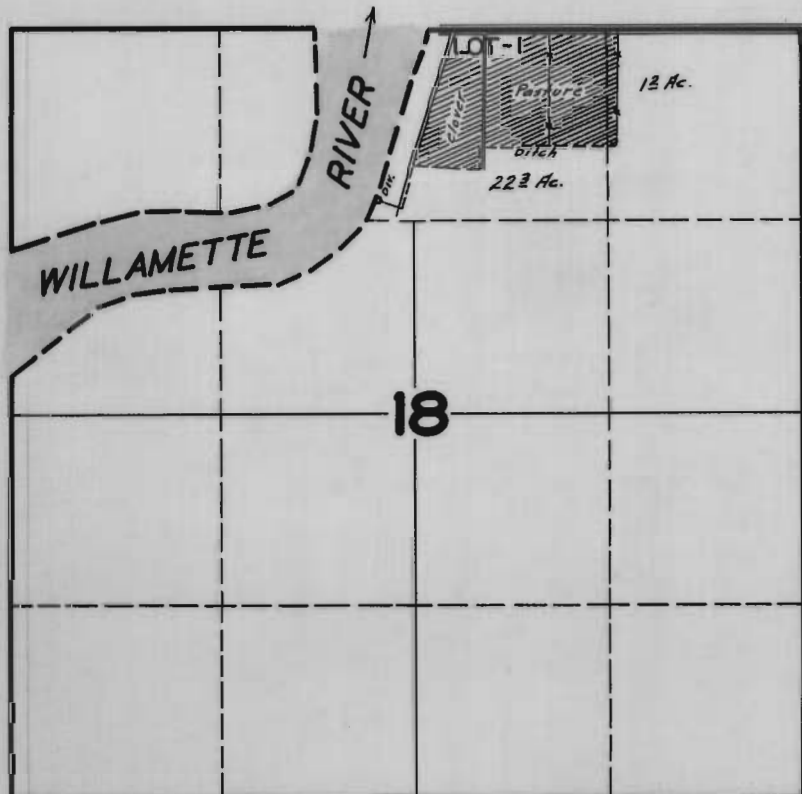

**FINAL PROOF SURVEY
UNDER**

Application No. 16473 Permit No. 12277

IN NAME OF
C. R. EVANS

Surveyed JUNE 28 1945, by *[Signature]*