


# T.2S. R.2E.W.M.

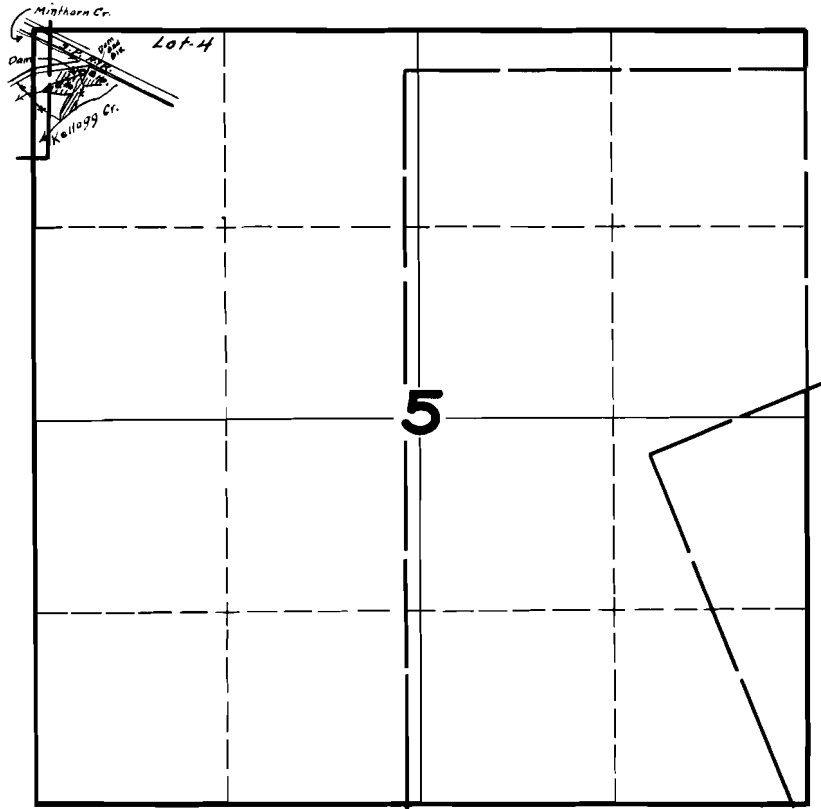

## FINAL PROOF SURVEY UNDER

Application No. 16950 Permit No. 12714

IN NAME OF

HORACE PERCIVAL MADDISON

Surveyed JULY 3 1945, by *James C. Russell*