


# T. 7S. R. 4W. W.M.

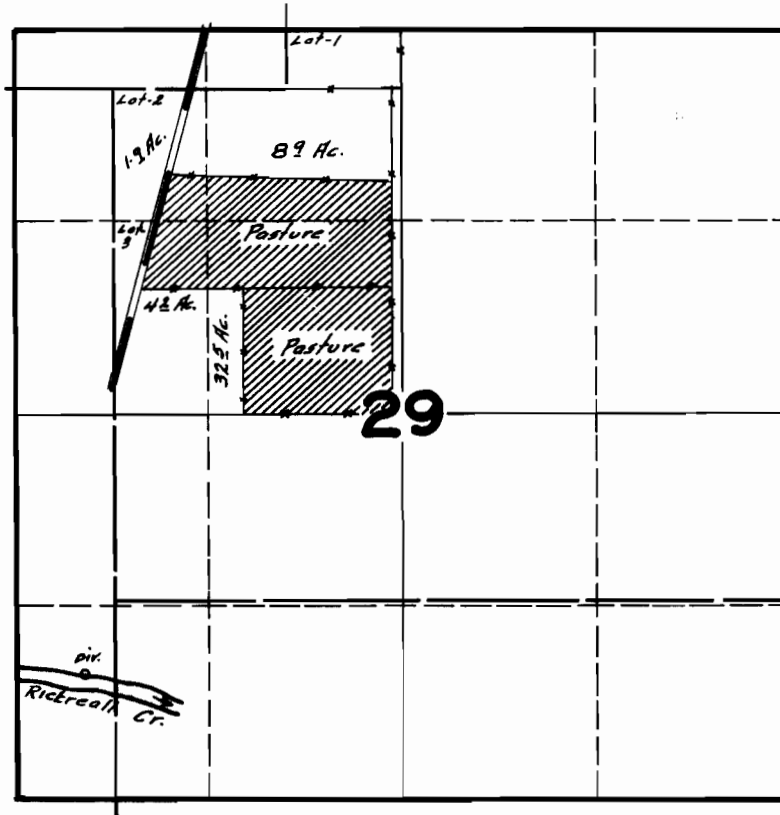

## FINAL PROOF SURVEY UNDER

Application No. 17166 Permit No. 12883

IN NAME OF

M.C. FINDLEY

Surveyed AUG. 11, 1945, by