


T.13S. R.1W.W.M.

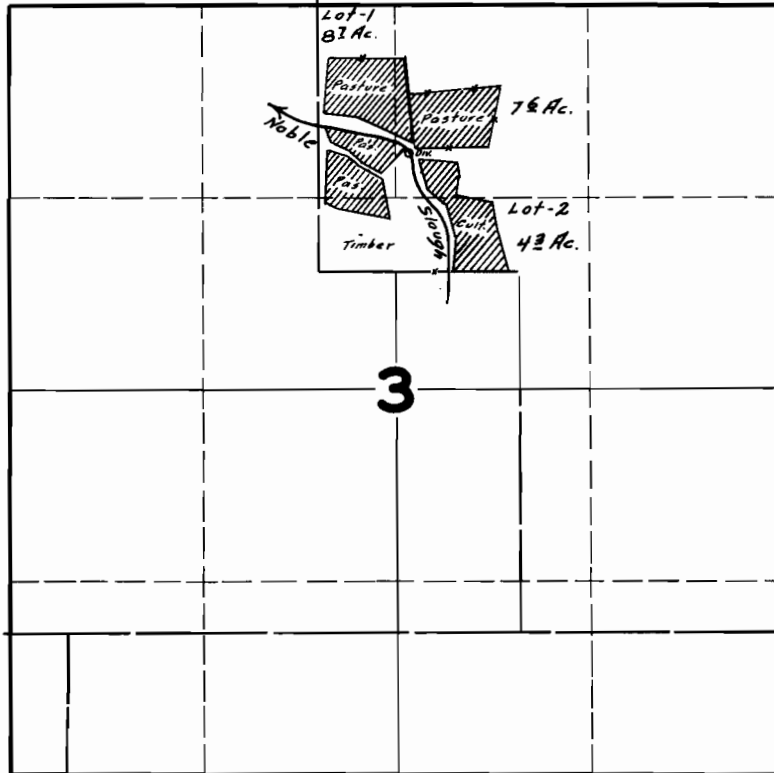

FINAL PROOF SURVEY UNDER

Application No. 17567 Permit No. 13267

IN NAME OF

MAGGIE E. COLLINS

Surveyed JUNE 30 1945, by

[Handwritten Signature]