


T. 12S. R. 3W. W.M.

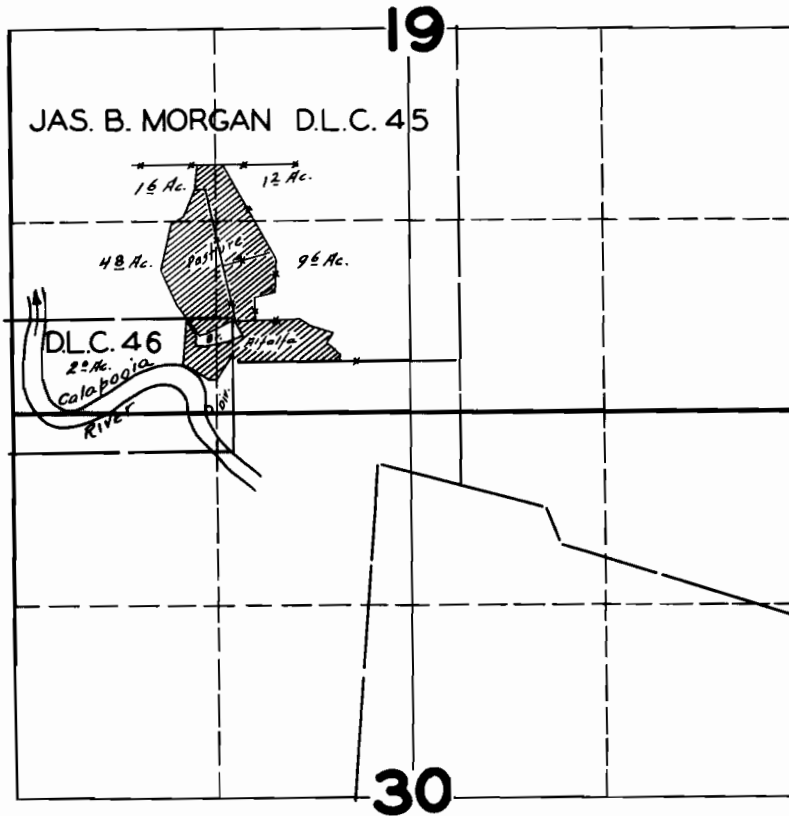

FINAL PROOF SURVEY UNDER

Application No. 17595 Permit No. 13291

IN NAME OF

F. R. JOHNSON

Surveyed JUNE 25 1945, by