


T.4 & 5S.R.4W.W.M.

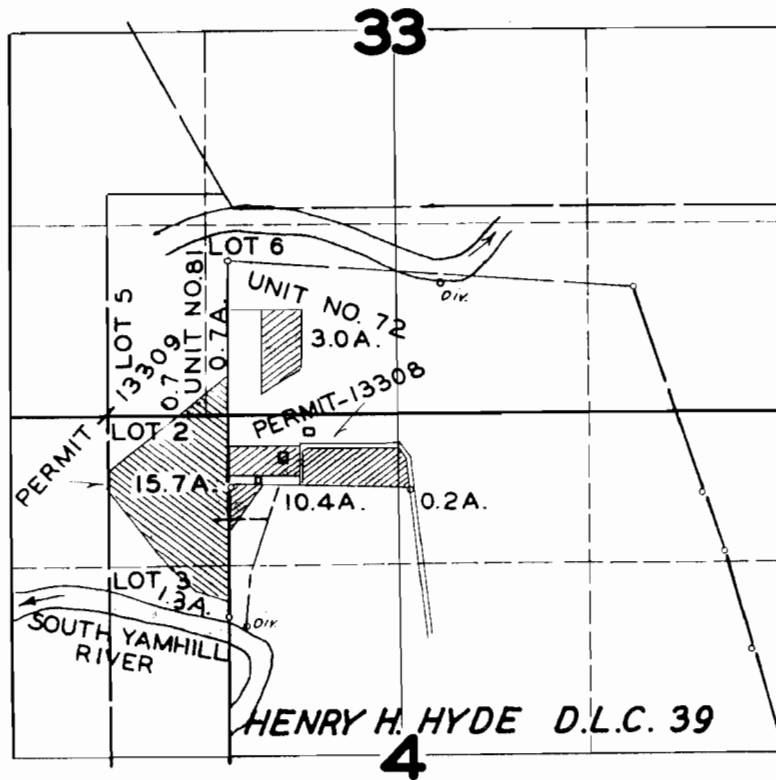

FINAL PROOF SURVEY

UNDER

Application No. 17619 13308
17620 13309

IN NAME OF

VEARL & LENA F. GOSS

Surveyed MAR. 21 1947, by JAS. E. BUNNELL