


# T.4 & 5S.R.4W.W.M.

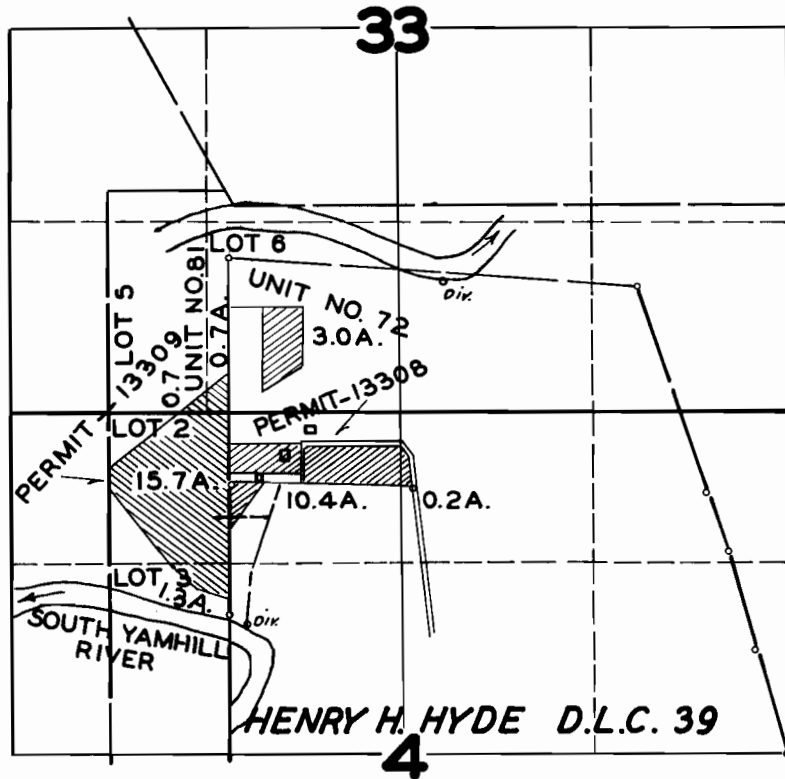

## FINAL PROOF SURVEY

UNDER

Application No. 17619 17620 Permit No. 13308 13309

IN NAME OF

VEARL & LENA F. GOSS

Surveyed MAR. 21. 1947. by JAS. E. BUNNELL