


T. 1 S. R. 2 W. W. M.

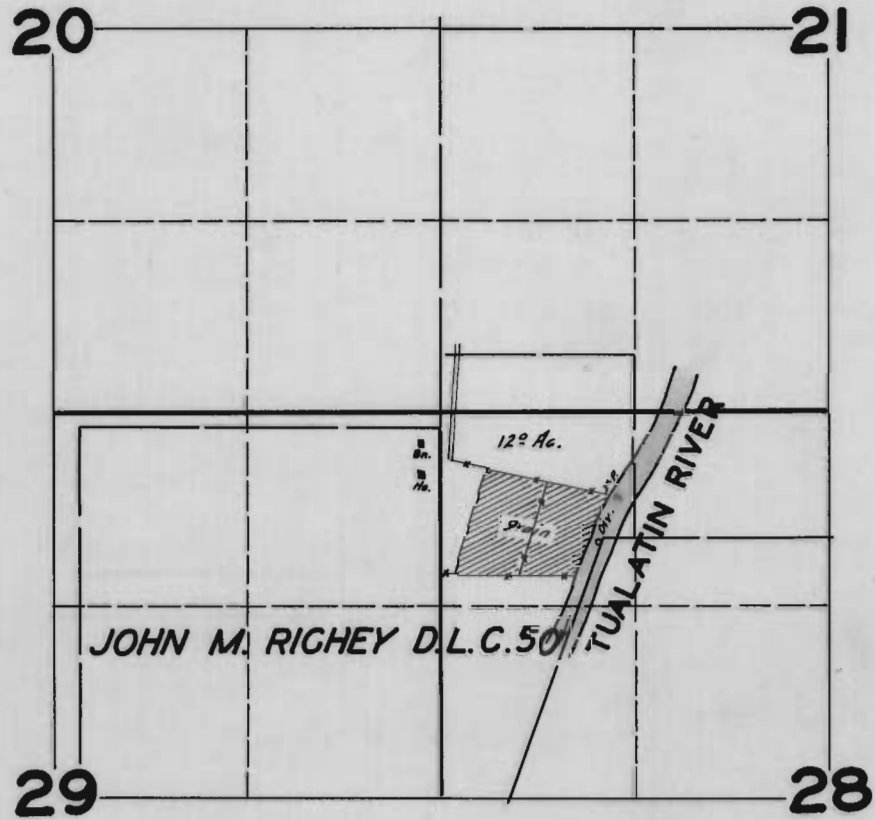

**FINAL PROOF SURVEY**  
UNDER

Application No. 17752 Permit No. 13445

IN NAME OF

OLE & HANZINA I. ERICKSON

Surveyed AUG. 27 1945, by [Signature]