


T.5S.R.5W.W.M.

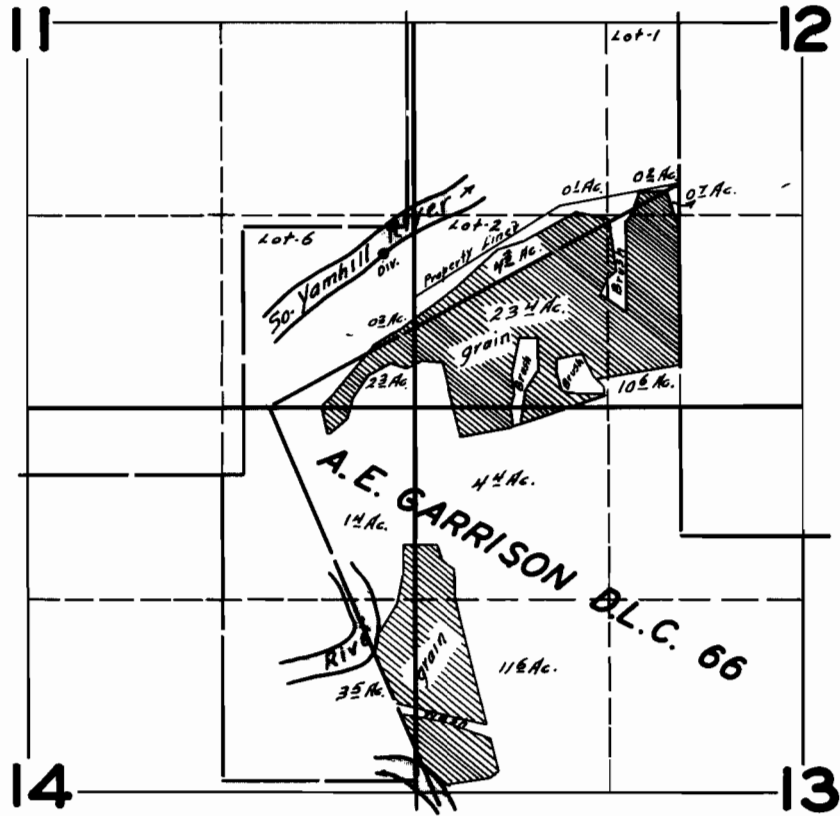

FINAL PROOF SURVEY UNDER

Application No. 17770 Permit No. 13457

IN NAME OF

MRS. GEORGE C. FULLER

Surveyed JUNE 7, 1945, by *[Signature]*