


T.2N. R.4 W.W.M.

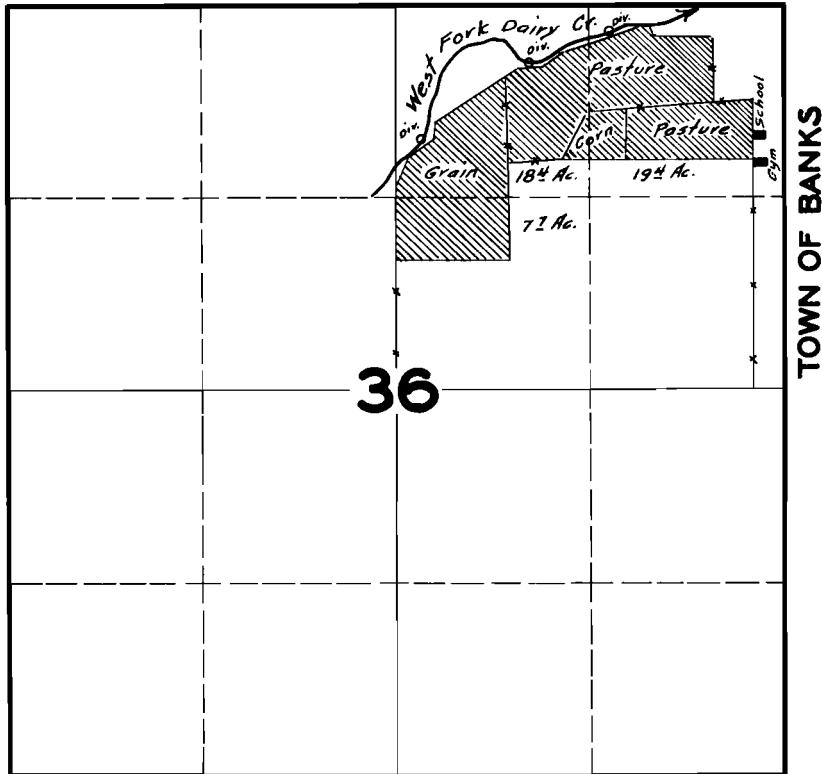

FINAL PROOF SURVEY UNDER

Application No. 17801 Permit No. 13480

IN NAME OF

HENRY VANDERZANDEN

Surveyed AUG. 31, 1945, by