


T.13S.R.1W.W.M.

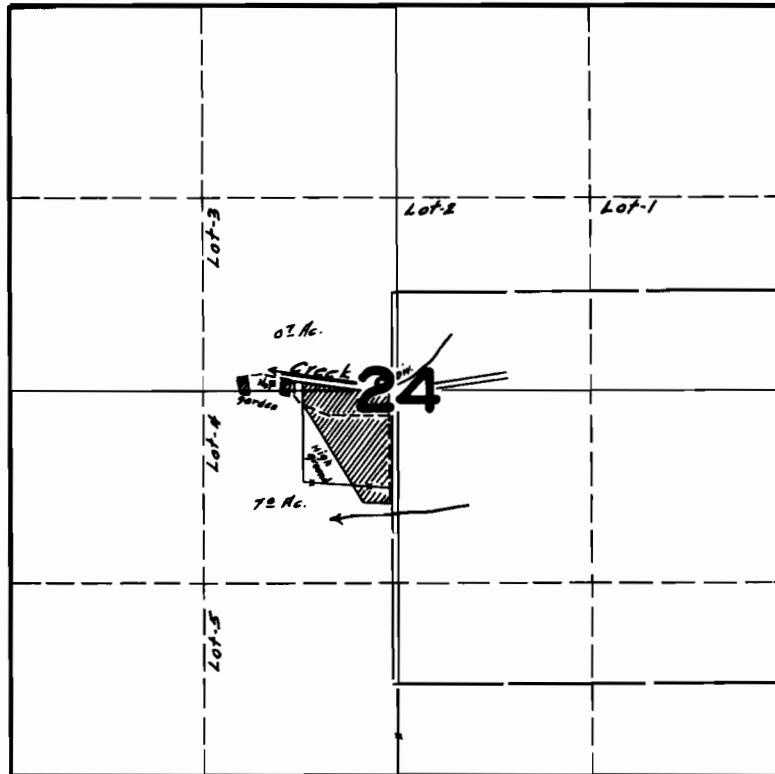

**FINAL PROOF SURVEY
UNDER**

Application No. 17892 Permit No. 13514

IN NAME OF

ALBERT A. MILLER

Surveyed JUNE 27 1945 by

[Signature]