


# T.5S. R.1W.W.M.

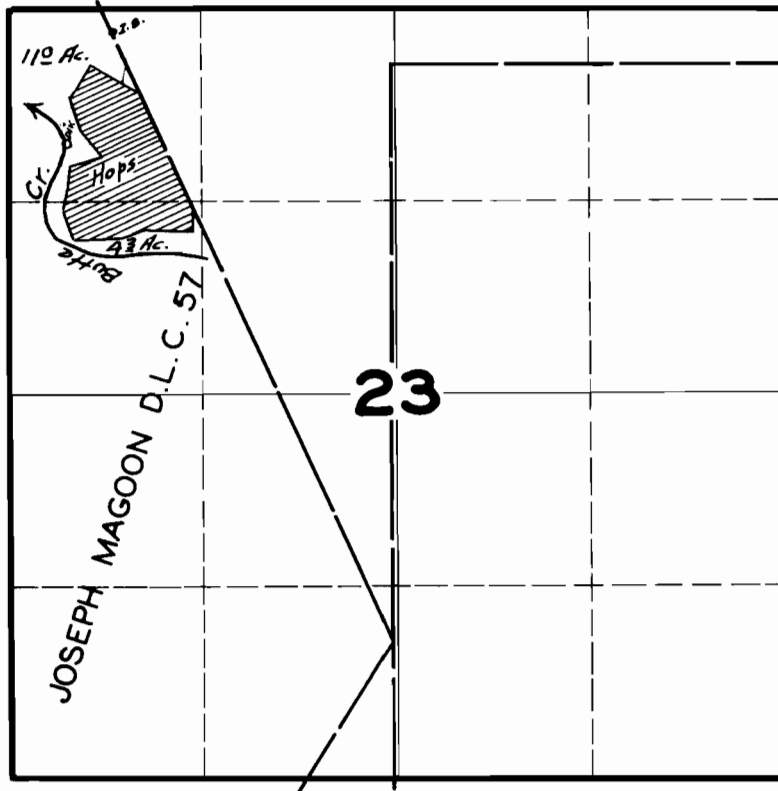

## FINAL PROOF SURVEY UNDER

Application No. 17878 Permit No. 13551

IN NAME OF  
GEORGE DAVIS

Surveyed MAY 3, 1945, by [Signature]