


T.5S. R.1E.W.M.

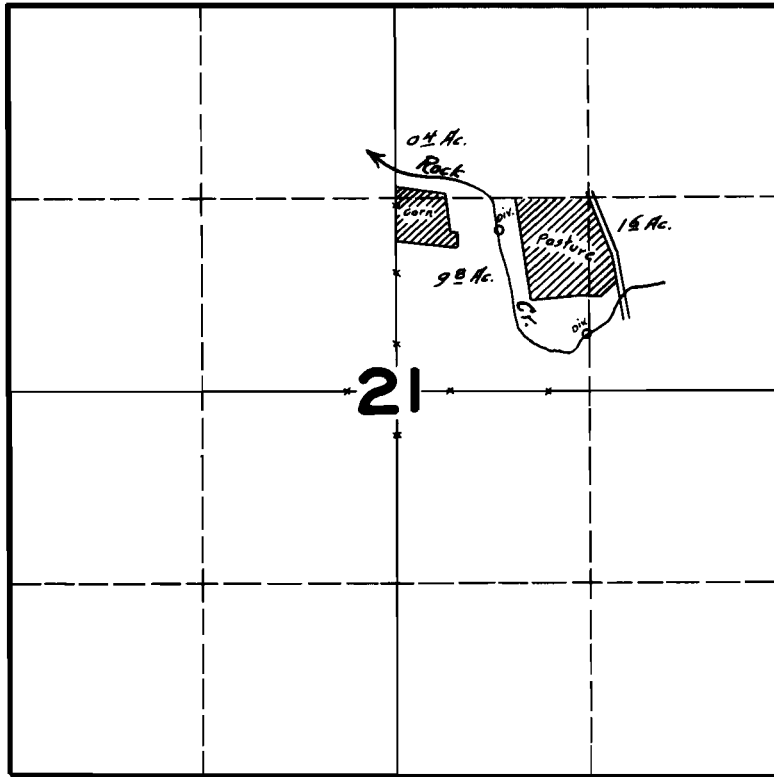

FINAL PROOF SURVEY UNDER

Application No. 17905 Permit No. 13592

IN NAME OF
LORINE WROLSTAD

Surveyed MAY 3 1945, by

J. J. Russell