


# T. IN. R. 2W.W.M.

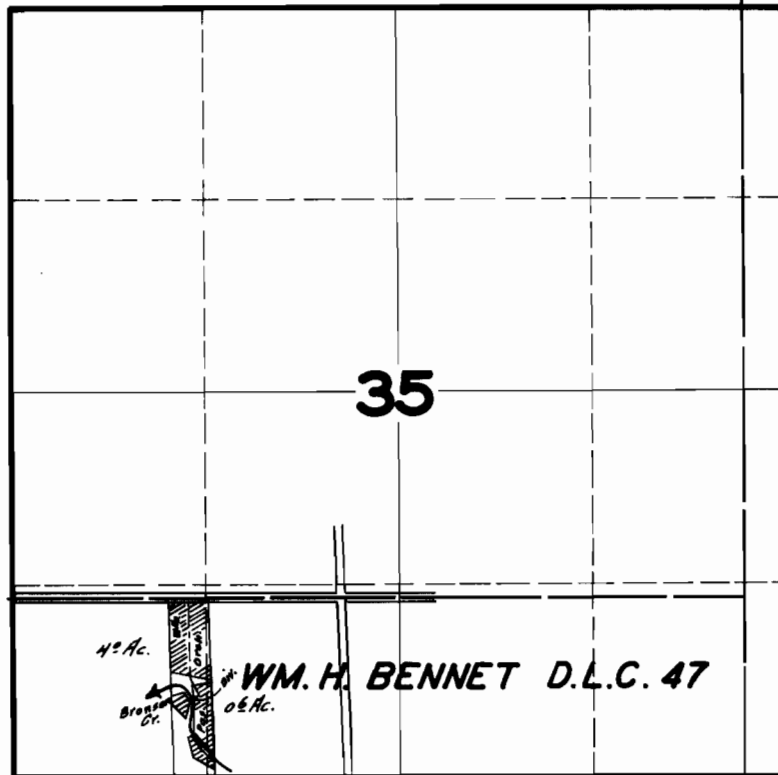

## FINAL PROOF SURVEY UNDER

Application No. 17913 Permit No. 13599

IN NAME OF

E. J. MEIHOFF

Surveyed AUG. 28 1945