


T.10S.R.10W.W.M.

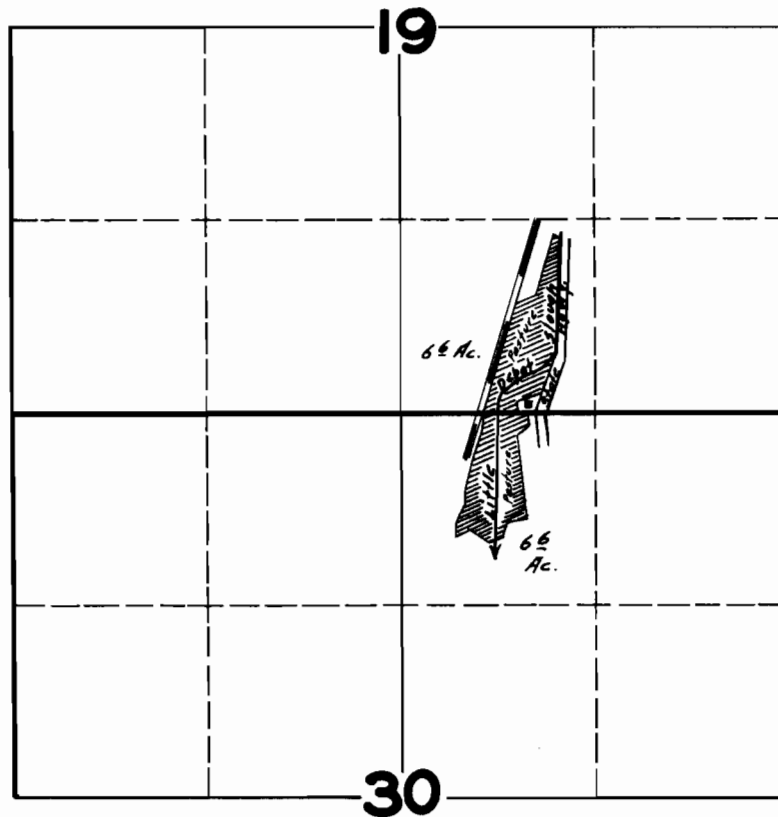

**FINAL PROOF SURVEY
UNDER**

Application No. 17988 Permit No. 13662

IN NAME OF
ERIC BAHRKE

Surveyed AUG. 21, 1945, by W. H. Bunnell