


T.10&11S. R.3&4W.W.M.

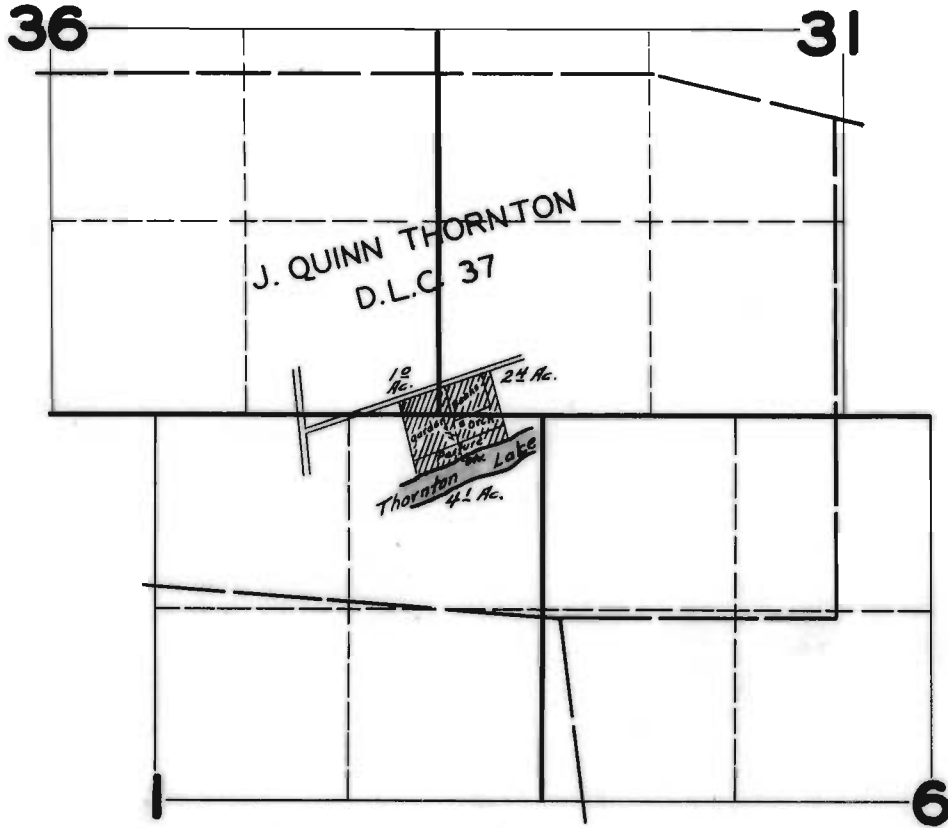

FINAL PROOF SURVEY
UNDER

Application No. 18065 Permit No. 13731

IN NAME OF

S. M. SNIDER.

Surveyed JULY 7, 1945, by