


T. 1 N. R. 3 W. W. M.

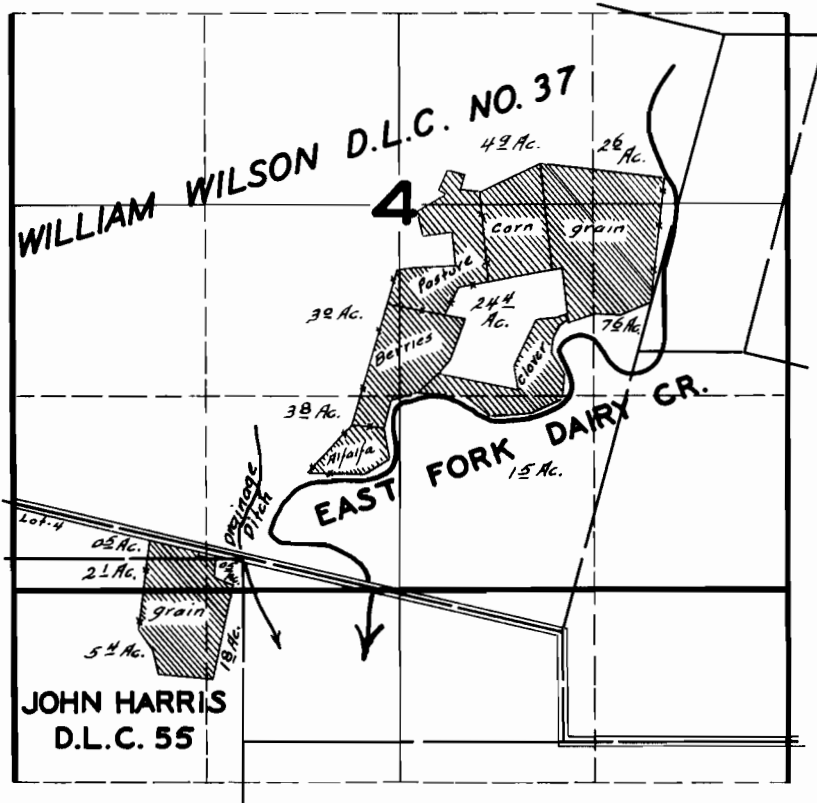

FINAL PROOF SURVEY UNDER

Application No. 18066 Permit No. 13732

IN NAME OF

F. M. VANDERZANDEN

Surveyed AUG. 30 1942, by *[Signature]*