


T.3S. R.5W.W.M.  
T.3S. R.4W.W.M.

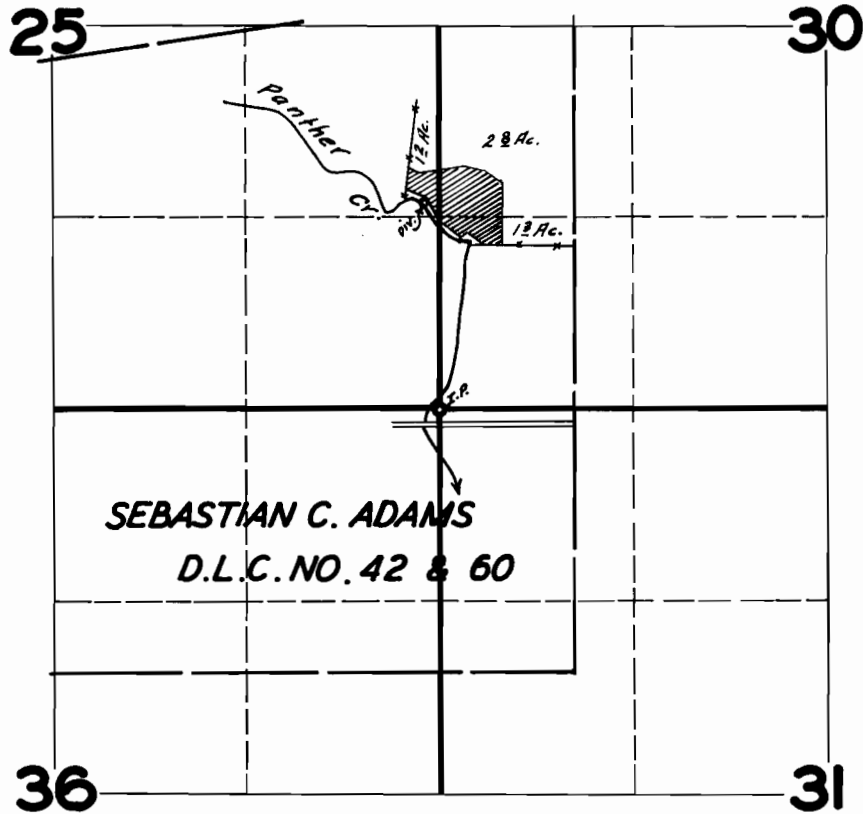

**FINAL PROOF SURVEY**  
UNDER

Application No. 18132 ... Permit No. 13780

IN NAME OF

M. DELL WOOD

Surveyed JUNE 28 1944, by