


T.30S. R.5W.W.M.

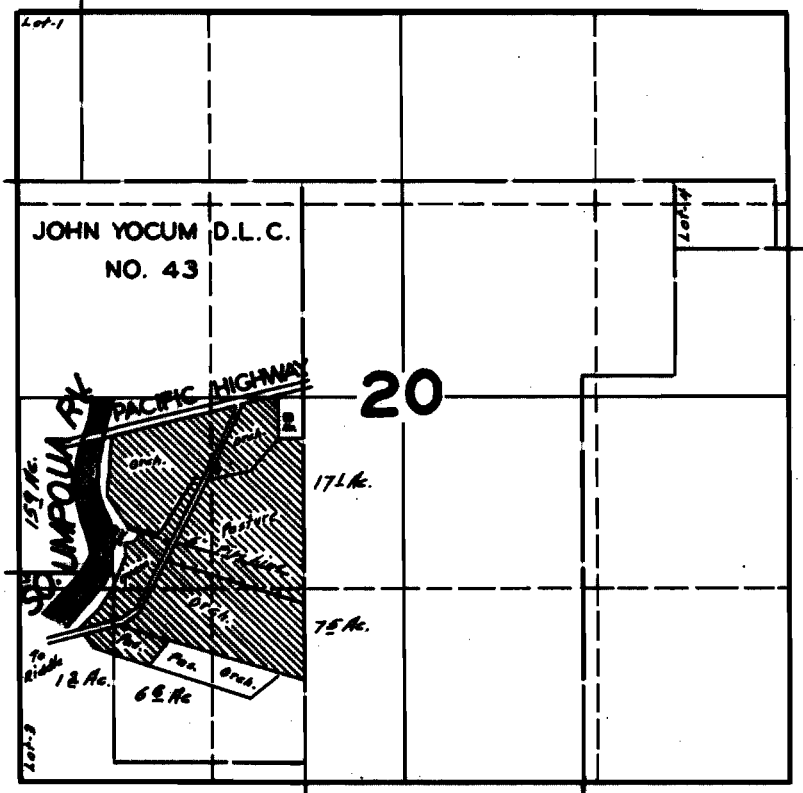

FINAL PROOF SURVEY UNDER

Application No. 18184 Permit No. 13814

IN NAME OF

T. T. SULLIVAN

Surveyed JULY 12 1945 *[Signature]*