


T.2S. R. 2E.W.M.

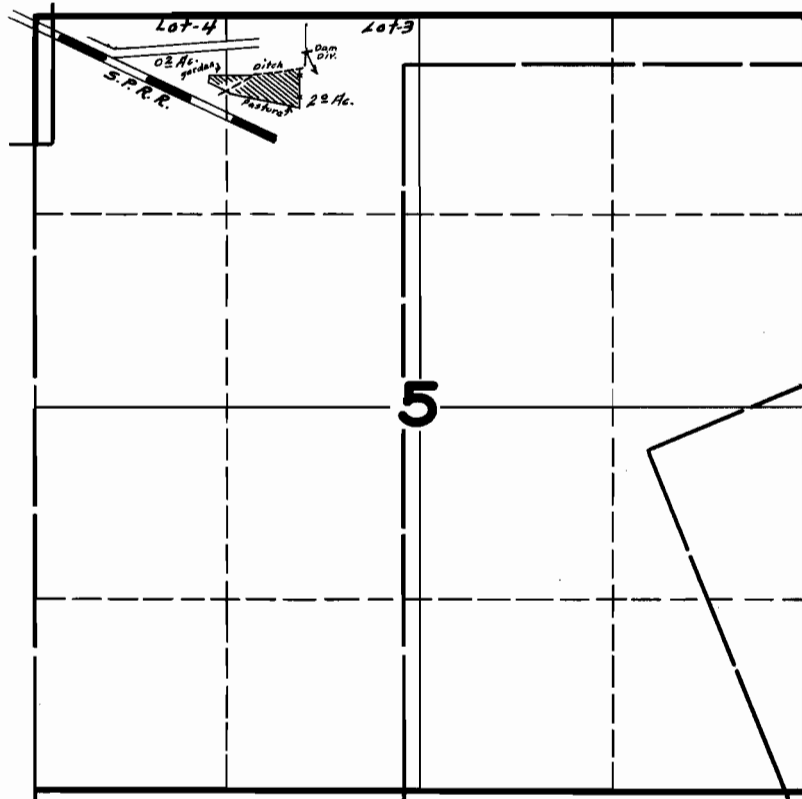

FINAL PROOF SURVEY UNDER

Application No. 17893 Permit No. 13852

IN NAME OF
F. C. BAKER.

Surveyed JULY 3, 1945, by *Frank Sumrell*