


T. 1 S. R. 4 W. W. M.

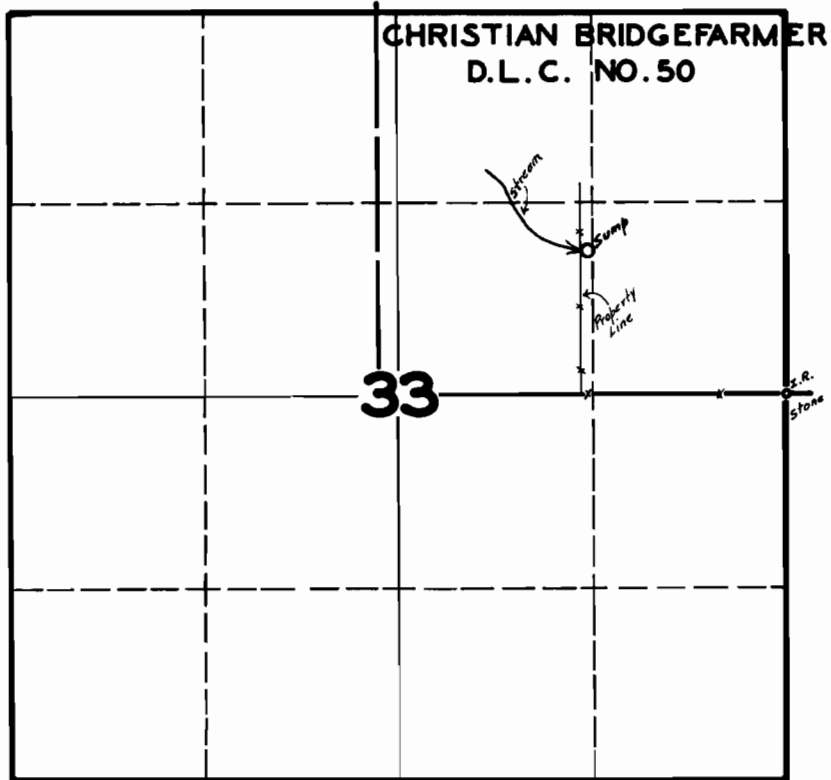

FINAL PROOF SURVEY UNDER

Application No. 18045 Permit No. 13867

IN NAME OF

ORAL MC. LEOD

Surveyed AUG. 31 1945, by