


T.2S.R.2W.W.M.

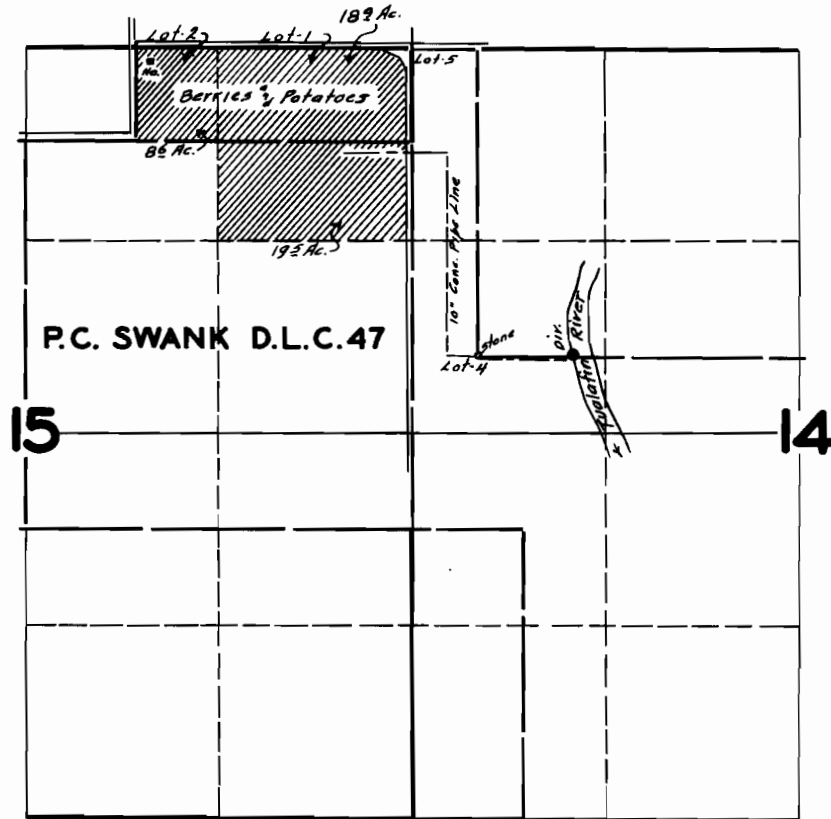

FINAL PROOF SURVEY UNDER

Application No. 18166 Permit No. 13877

IN NAME OF

F. E. ROWELL & J. A. ROWELL

Surveyed AUG. 24 1945, by [Signature]