


T.4 & 5 S. R. 4 W. W.M.

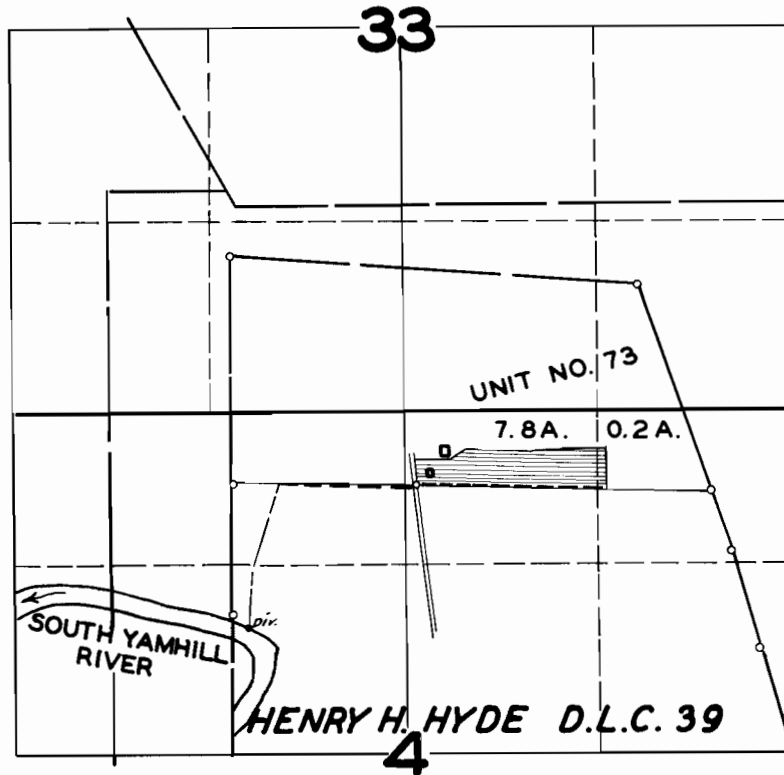

FINAL PROOF SURVEY UNDER

Application No. 18234 Permit No. 13895
IN NAME OF

GEORGE J. & ROSALIN GOSS

Surveyed MAR. 21, 1947, by JAS. E. BUNNELL