


T.3S. R.1E.W.M.

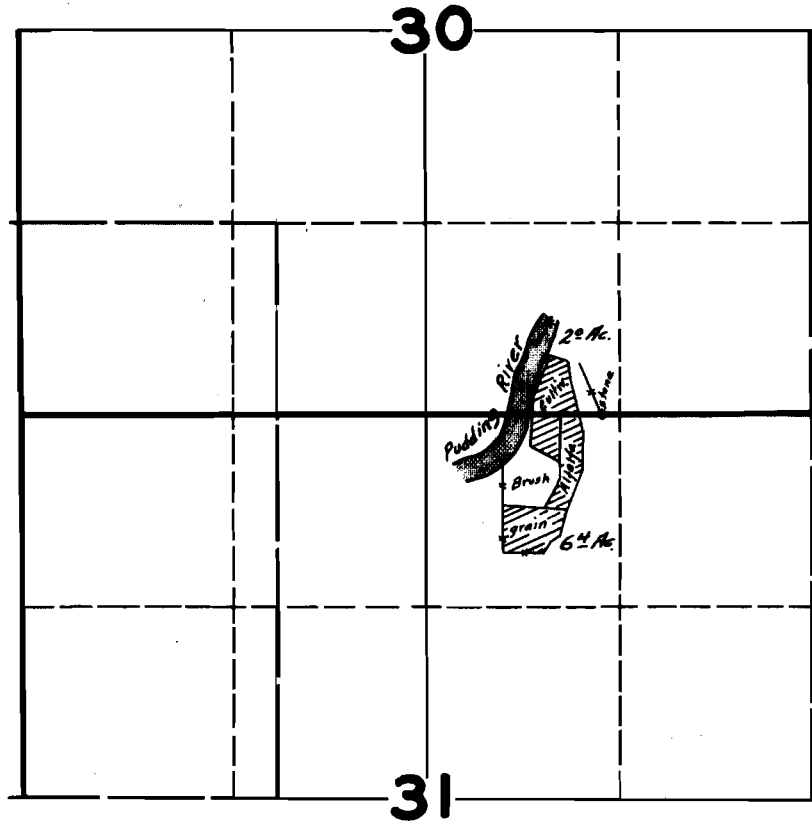

FINAL PROOF SURVEY UNDER

Application No. 18343 Permit No. 13974

IN NAME OF

FRED D. SIMMONS

Surveyed MAY 7, 1945, by *J. D. Russell*