


T.2S. R.2E.W.M.

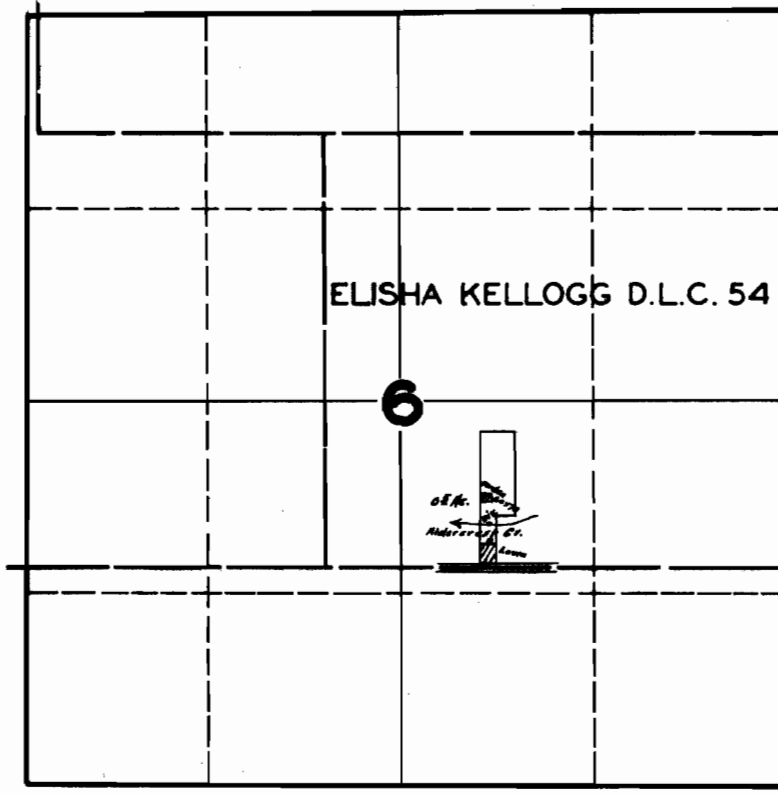

FINAL PROOF SURVEY
UNDER

Application No. 18,395 Permit No. 14034

IN NAME OF

A.W. WILLIAMS

Surveyed JULY 3, 1945 by [Signature]