


T.32S. R.15W.W.M.

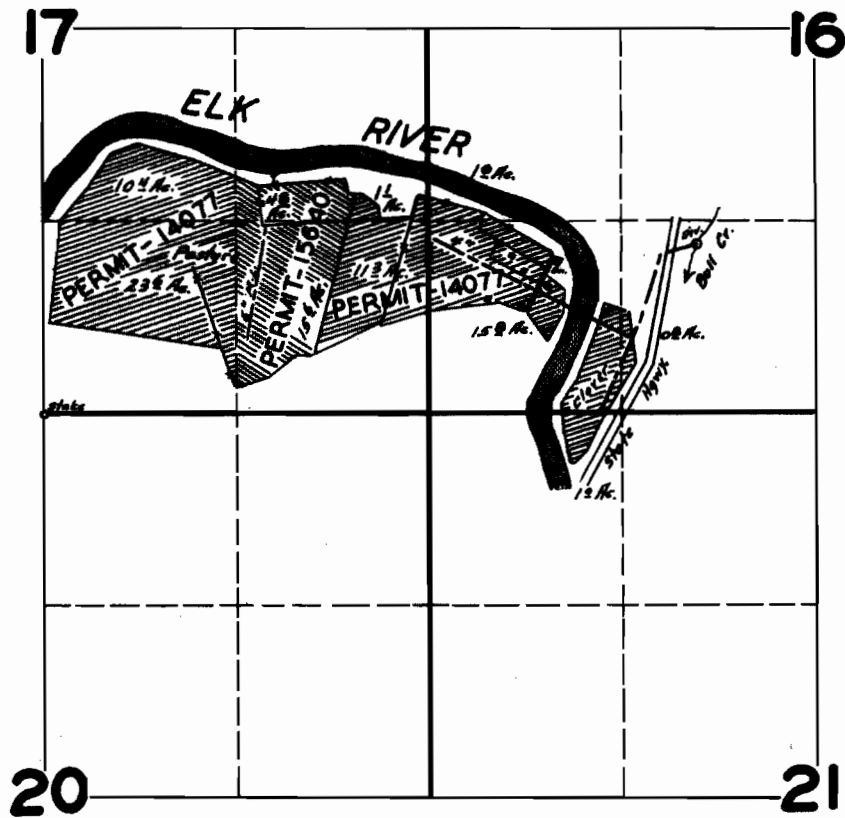

FINAL PROOF SURVEY

UNDER

18462

14077

Application No. 20071

Permit No. 15640

IN NAME OF

W. J. SWEET

Surveyed JULY 17, 1945, by