


T.14S.R.12W.W.M.

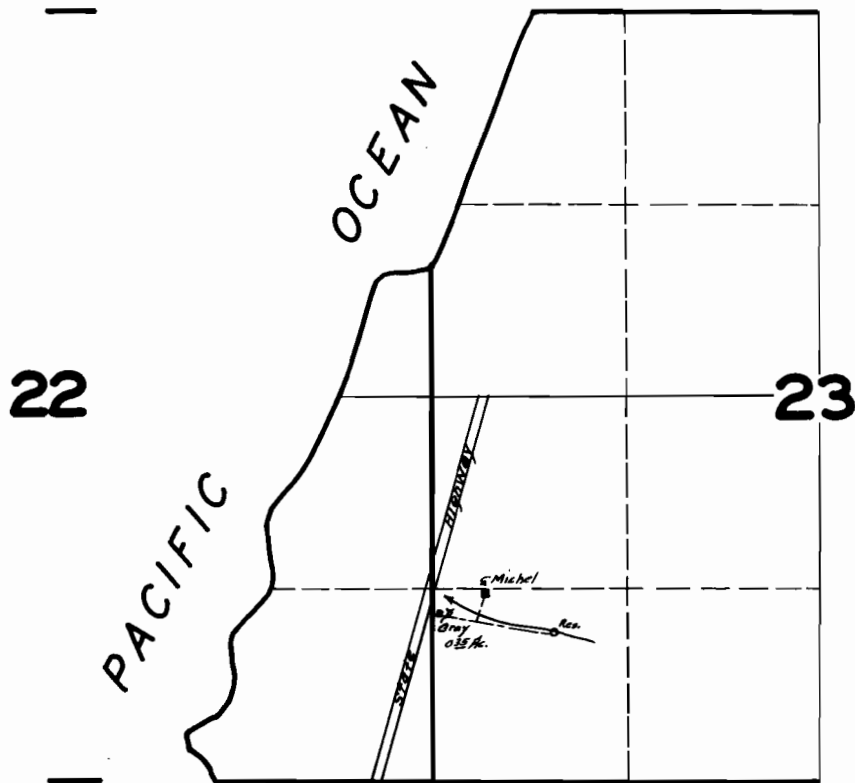

FINAL PROOF SURVEY
UNDER

Application No. 18410 Permit No. 14092

IN NAME OF

ARTHUR C. & MURIEL H. GRAY

Surveyed AUG. 8, 1945, by *[Signature]*