


T. 1S. R. 3W. W. M.

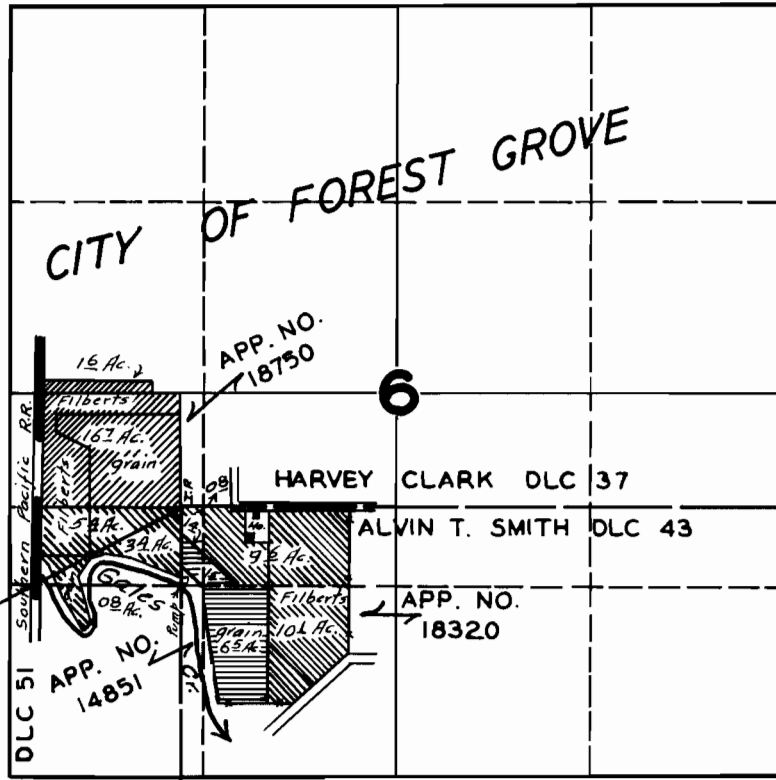

FINAL PROOF SURVEY

UNDER

18320

14099

Application No. 18750

Permit No. 14410

IN NAME OF

J. M. SWEET

Surveyed JULY 26 1944, by