


T.6S.R.IW.W.M.

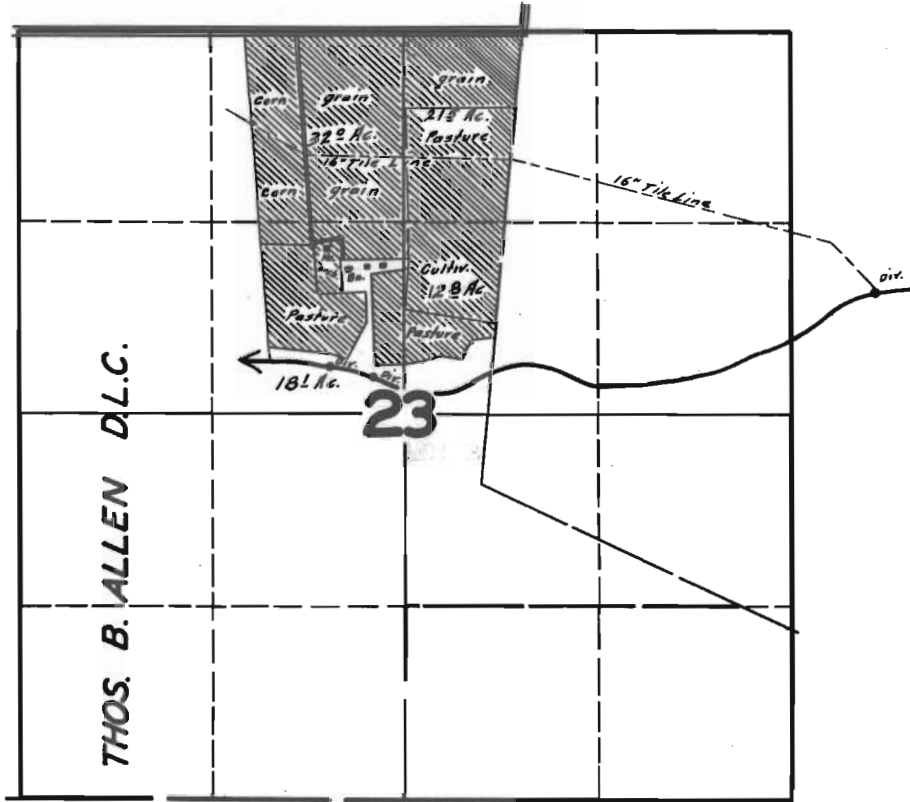

FINAL PROOF SURVEY

UNDER

Application No. 18556 Permit No. 14180
18776 14421

IN NAME OF

J. P. VANDECOEVERING

Surveyed JUNE 1 1945, by [Signature]