


T.36S. R.14W. W.M.

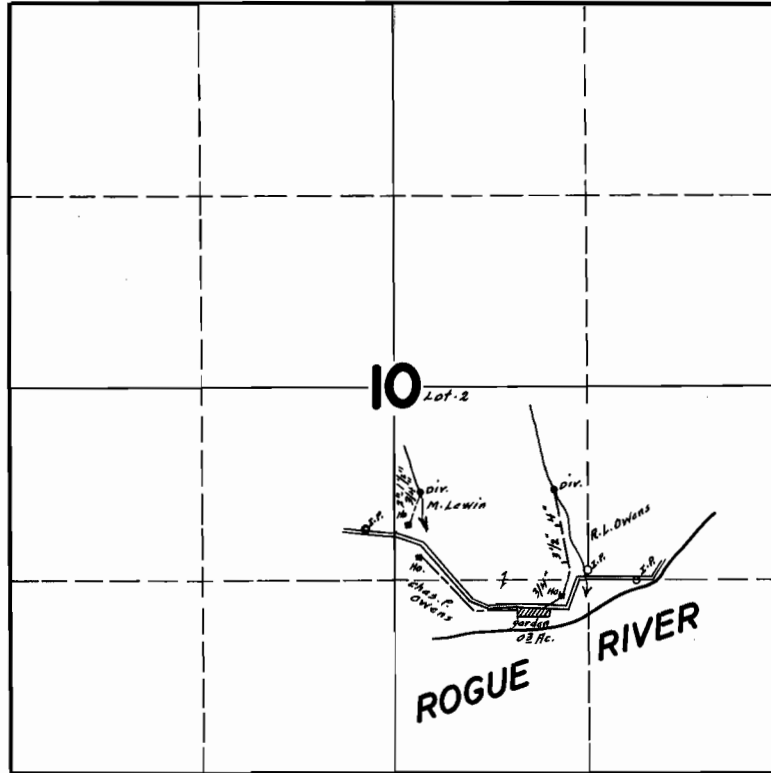

FINAL PROOF SURVEY
UNDER

Application No. 18601 Permit No. 14244

IN NAME OF

ROBERT L. OWEN

Surveyed JULY 16, 1945, by *James E. Sumrell*