


# T.28S. R.6W.W.M.

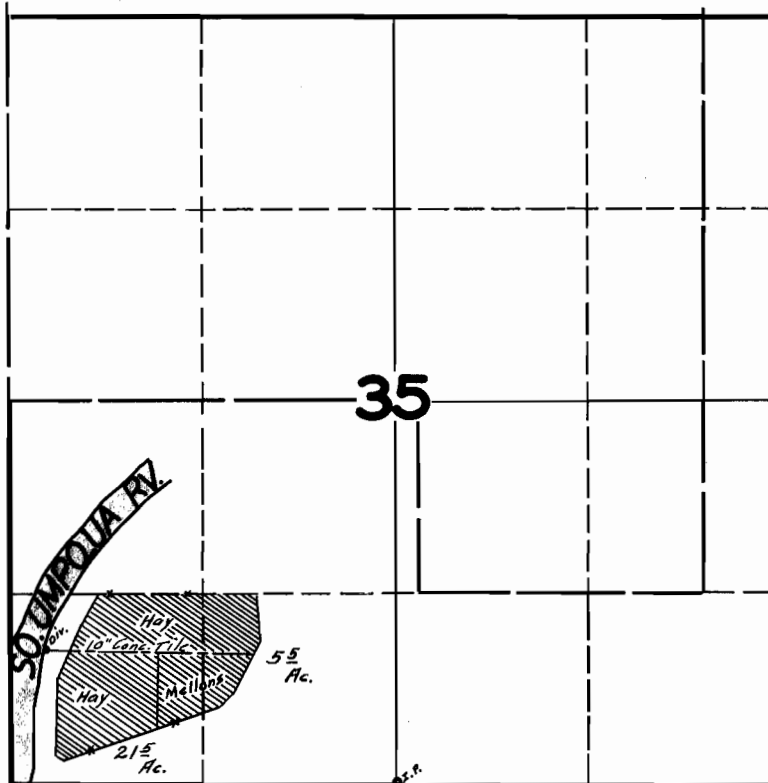

## FINAL PROOF SURVEY UNDER

Application No. 18609 Permit No. 14248

IN NAME OF  
F. D. COON

Surveyed JULY 12 1945, by *James E. Russell*