


T.11S. R.6W.W.M.

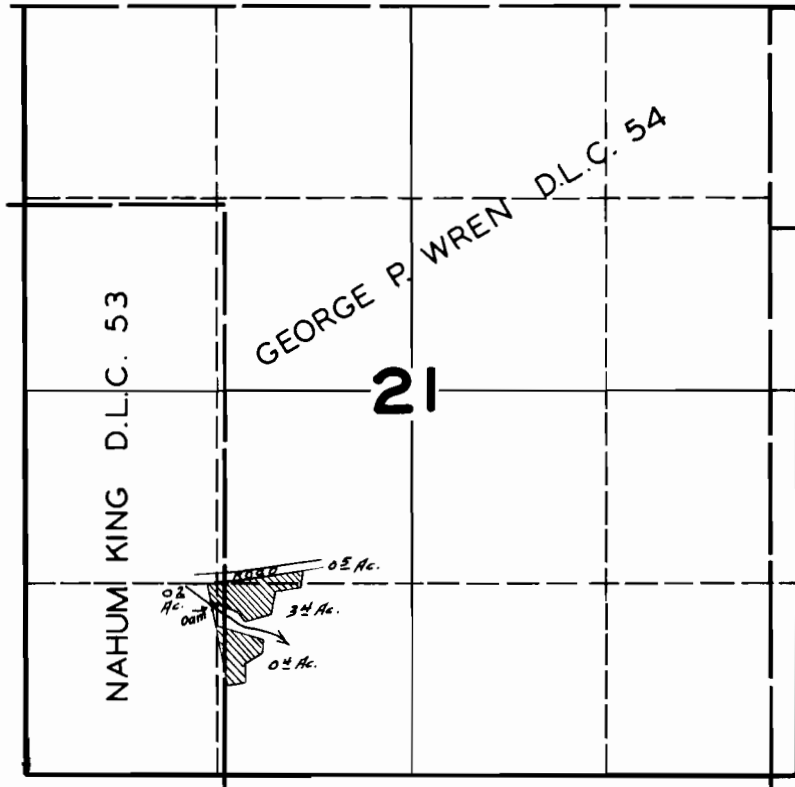

FINAL PROOF SURVEY

UNDER

Application No. 18661 Permit No. 14293

IN NAME OF

J. V. HUSS.

Surveyed JULY 27 1945, by