


T.5S. R.1E.W.M.

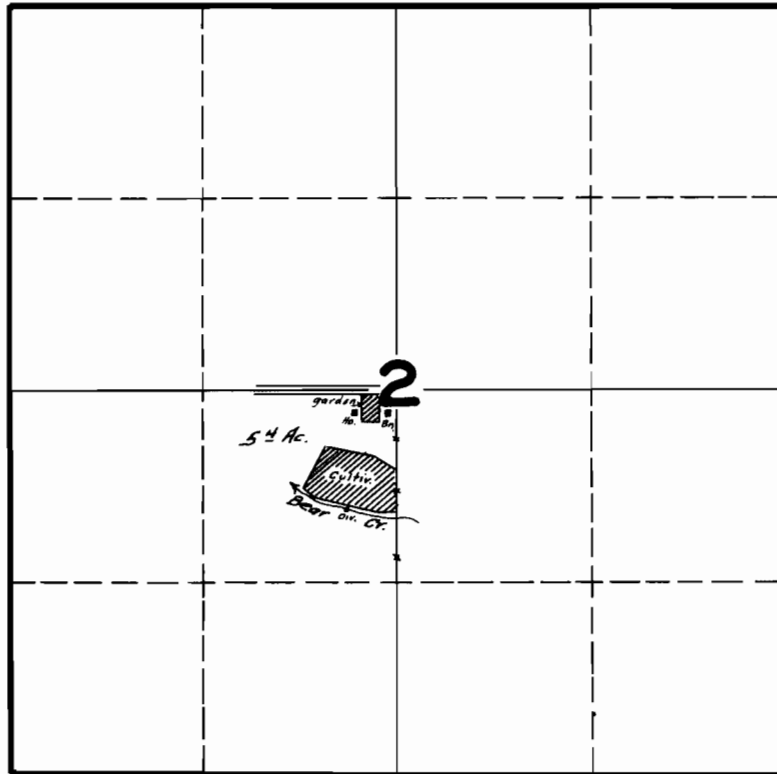

FINAL PROOF SURVEY
UNDER

Application No. 18739 Permit No. 14348

IN NAME OF

LAURA I. GILBERTSON

Surveyed SEPT. 5 1945, by

Robert J. Russell