


T.2S.R.5W.W.M.

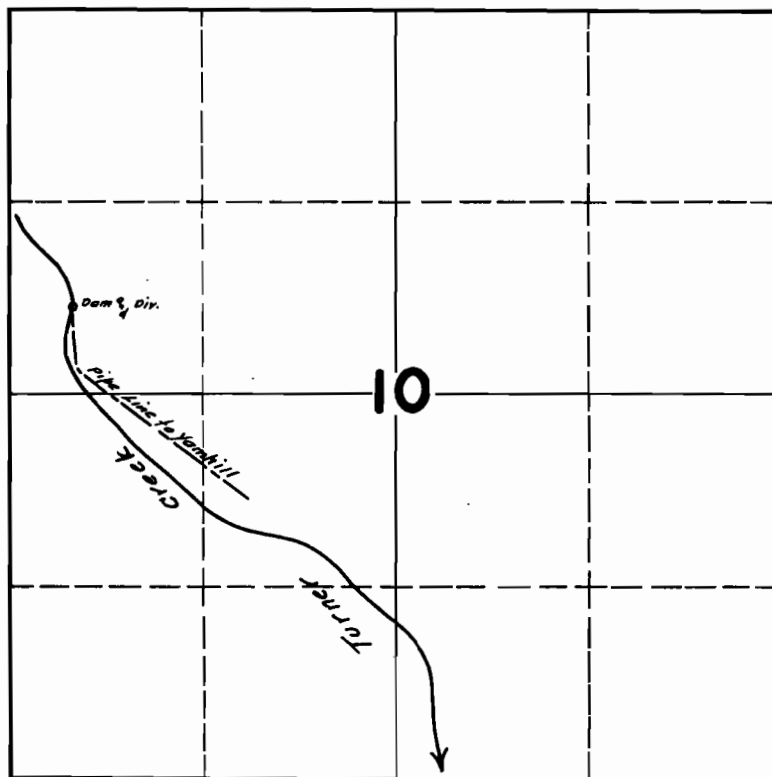

FINAL PROOF SURVEY
UNDER

Application No. 18627 Permit No. 14399

IN NAME OF
CITY OF YAMHILL

Surveyed JULY 2 1945, by [Signature]