


# T. 1 S. R. 3 W. W. M.

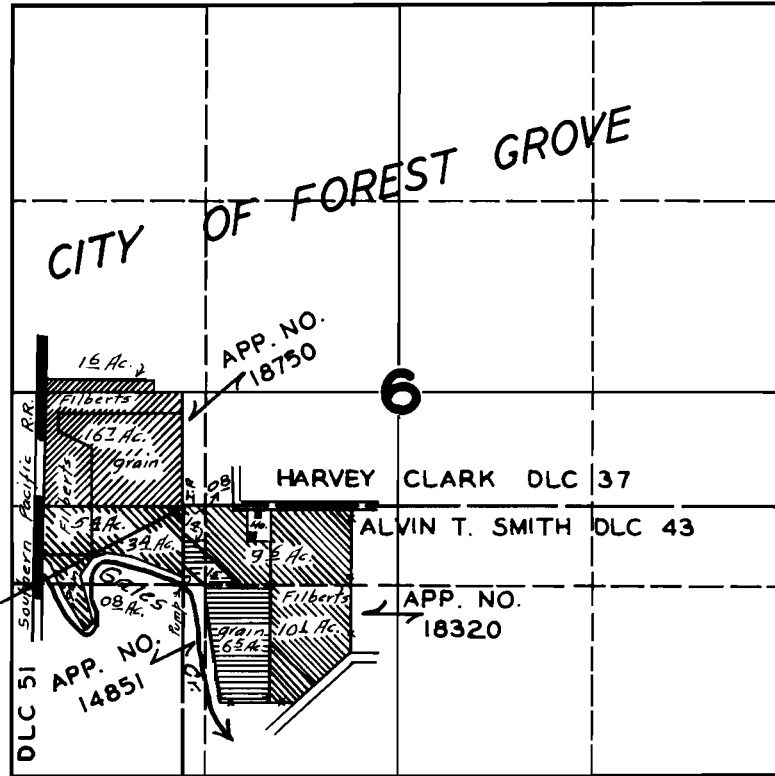

## FINAL PROOF SURVEY

UNDER

18320

14099

Application No. 18750 Permit No. 14410

IN NAME OF

J. M. SWEET

Surveyed JULY 26 1944, by