T.6S. R.1W.W.M.

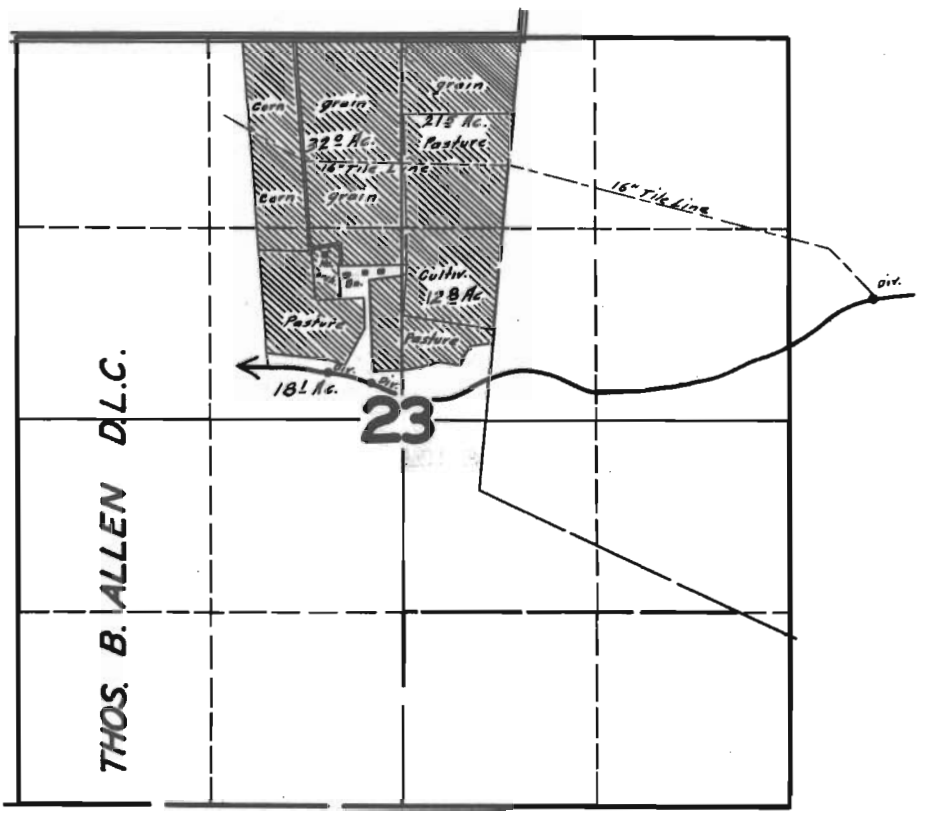

FINAL PROOF SURVEY

UNDER

Application No. 18556 18776 Permit No. 14180 14421

IN NAME OF

J. P. VANDECOEVERING

Surveyed JUNE 1 1945, by

1945-A