


T.2S.R.1W.W.M.

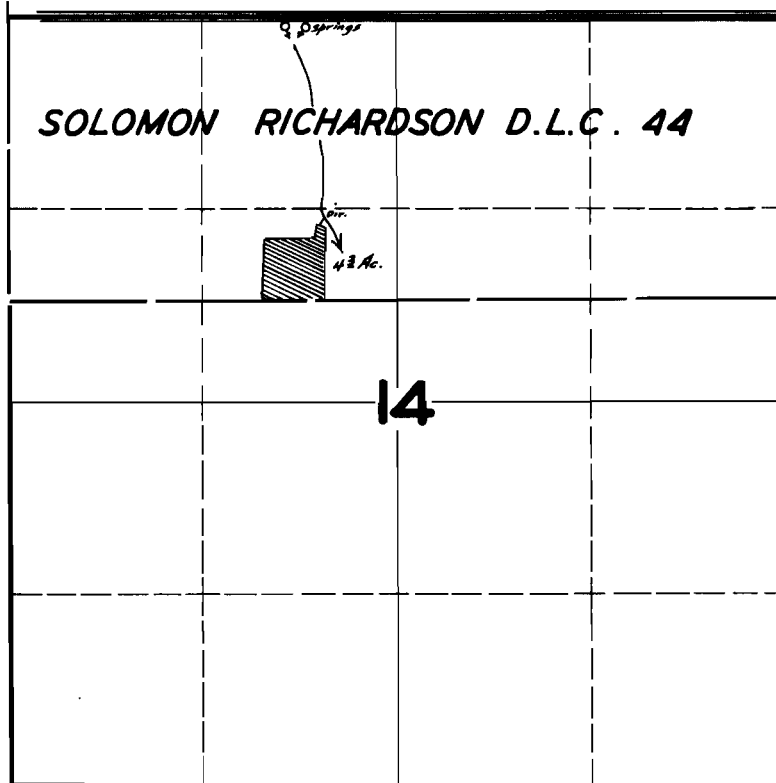

FINAL PROOF SURVEY UNDER

Application No. 18780 Permit No. 14425

IN NAME OF

HENRY P. FRISON

Surveyed AUG. 27 1945, by