


T. 28 S., R. 12 AND 13 W. W.M.

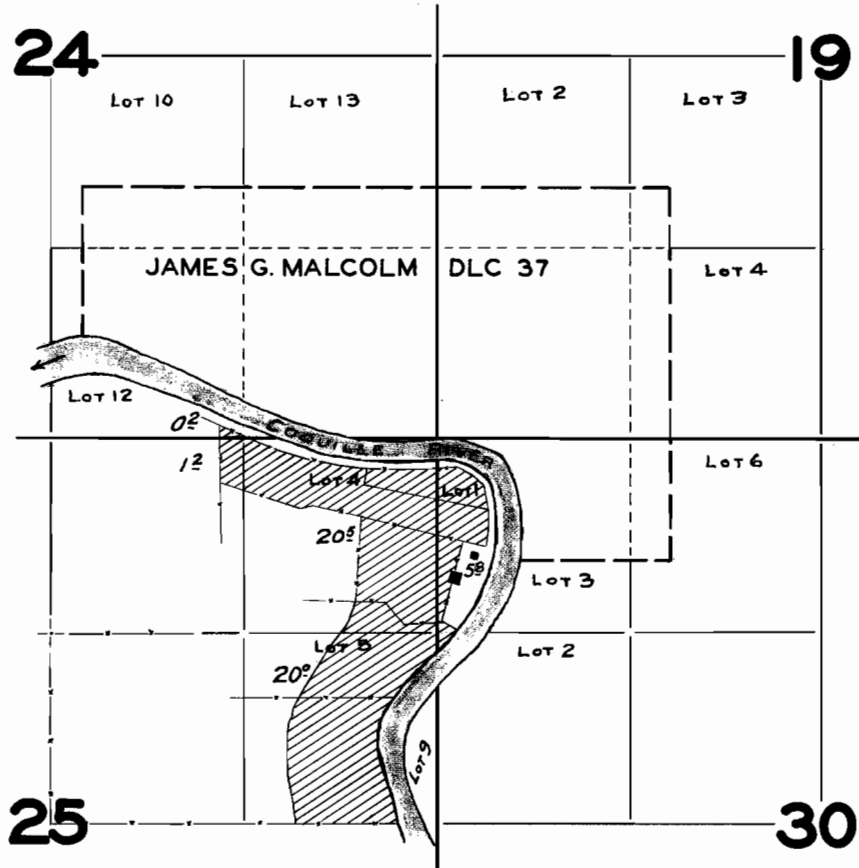

FINAL PROOF SURVEY
UNDER

Application No. 18822 Permit No. 14460

IN NAME OF

G. A. Collier

Surveyed Aug. 30 1943, by Geo. Maderman