


T.9S.R.4E.W.M.

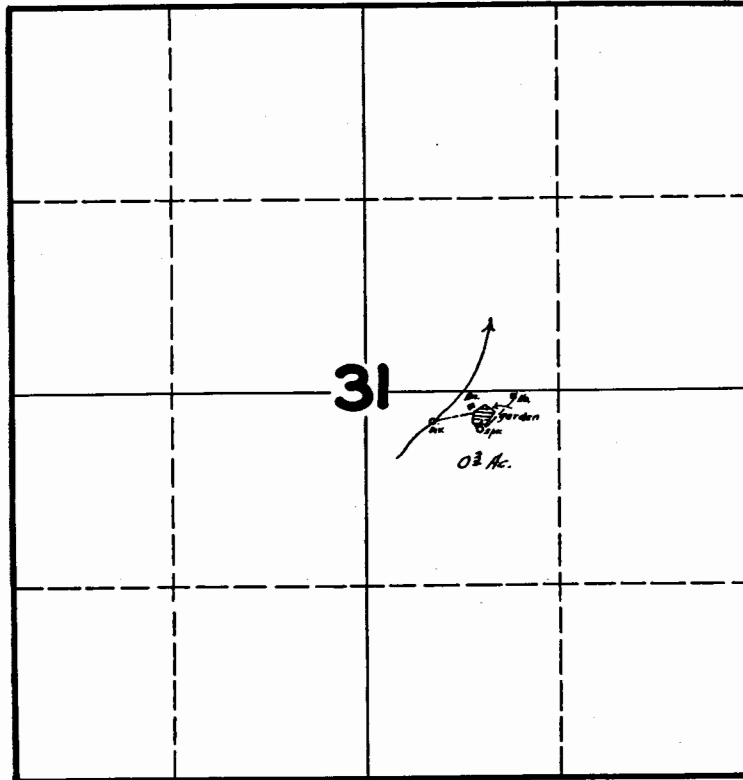

**FINAL PROOF SURVEY
UNDER**

Application No. 18847 Permit No. 14482

IN NAME OF

NORRIS J. THOMAS

Surveyed JULY 25 1945, by