


T.16S. R.2W.W.M.

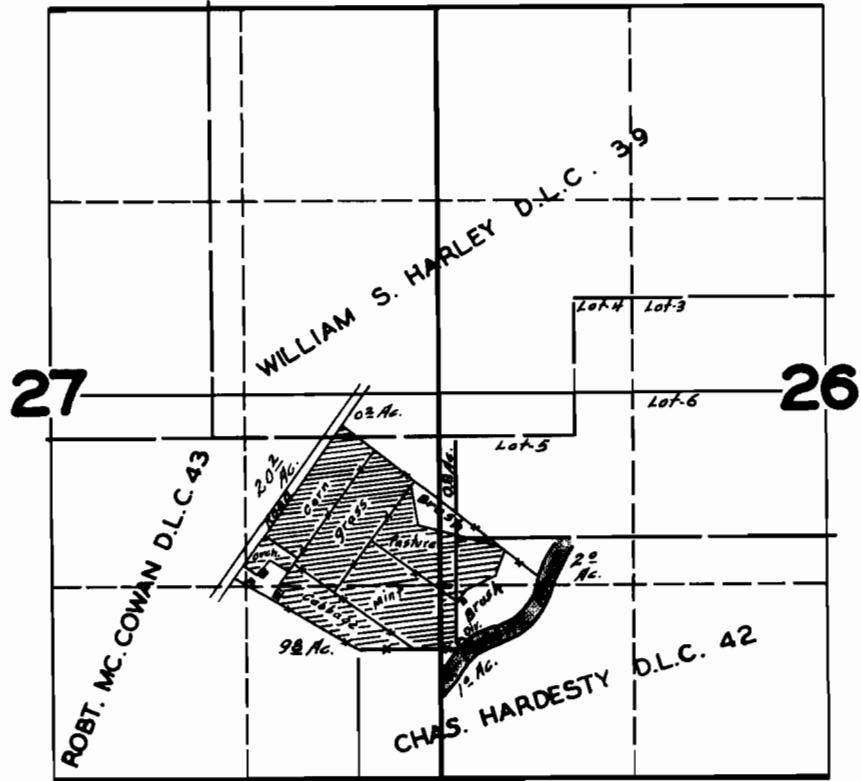

FINAL PROOF SURVEY

UNDER

Application No. 18874 Permit No. 14504

IN NAME OF

OSCAR H. BRUCE

Surveyed AUG. 2, 1945, by *J. H. Sunnell*