


T.19S. R.1W.W.M.

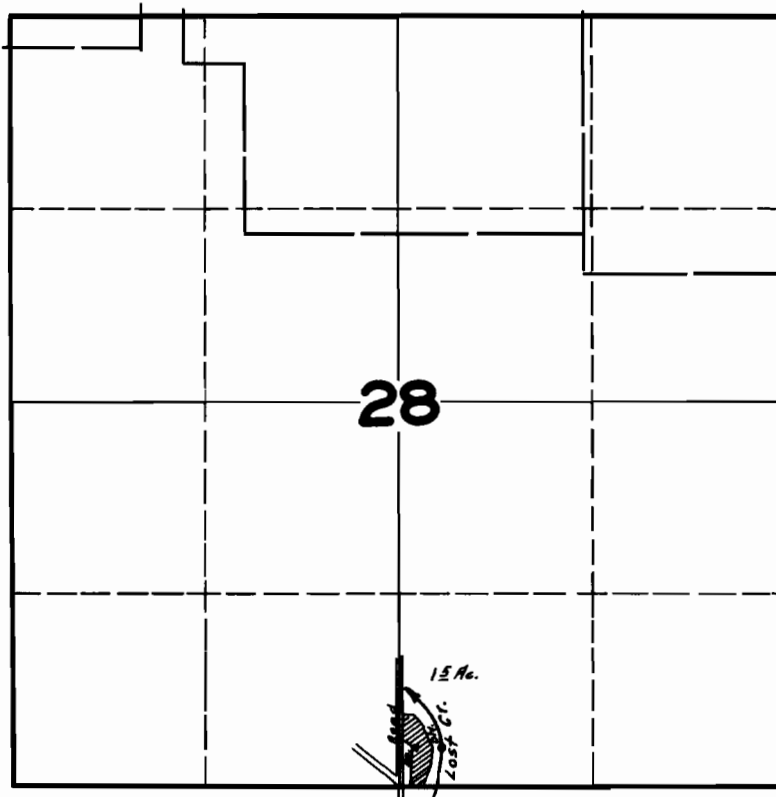

FINAL PROOF SURVEY

UNDER

Application No. 18892 Permit No. 14507

IN NAME OF

~~RICHARD KITTEL~~

Surveyed JULY 31 1945, by

NAME OF
RD. KITTEL
1945, by *[Signature]*