


T.17S. R.6&7W.W.M.

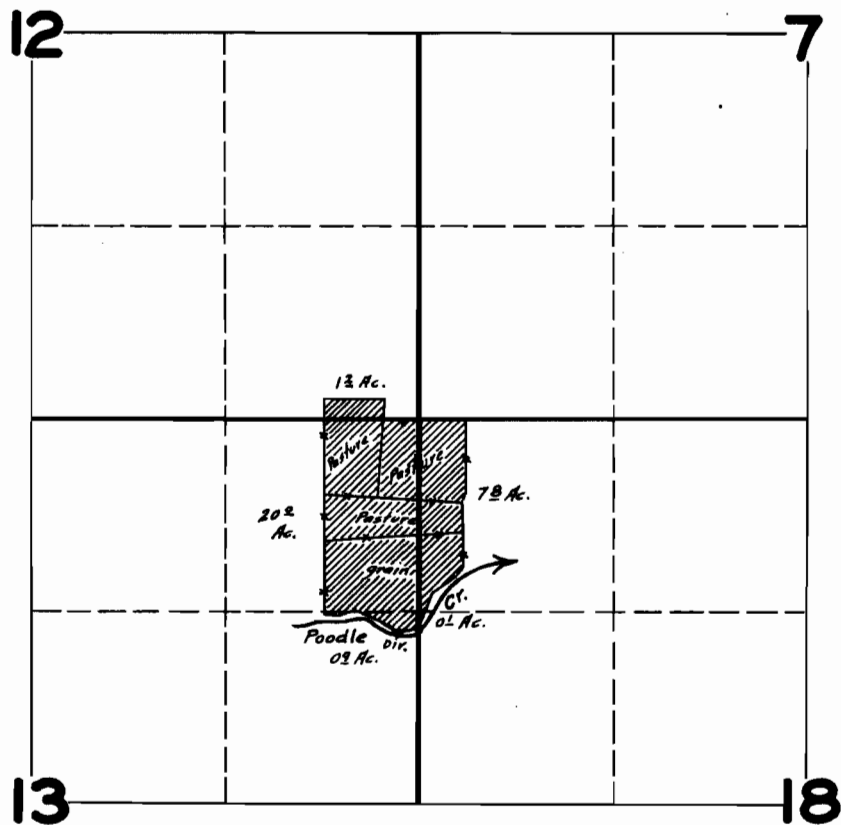

FINAL PROOF SURVEY
UNDER

Application No. 18902 Permit No. 14516

IN NAME OF

FRANK MONTGOMERY

Surveyed AUG. 3, 1945, by *James E. Crumell*