


T.3S. R.1W.W.M.

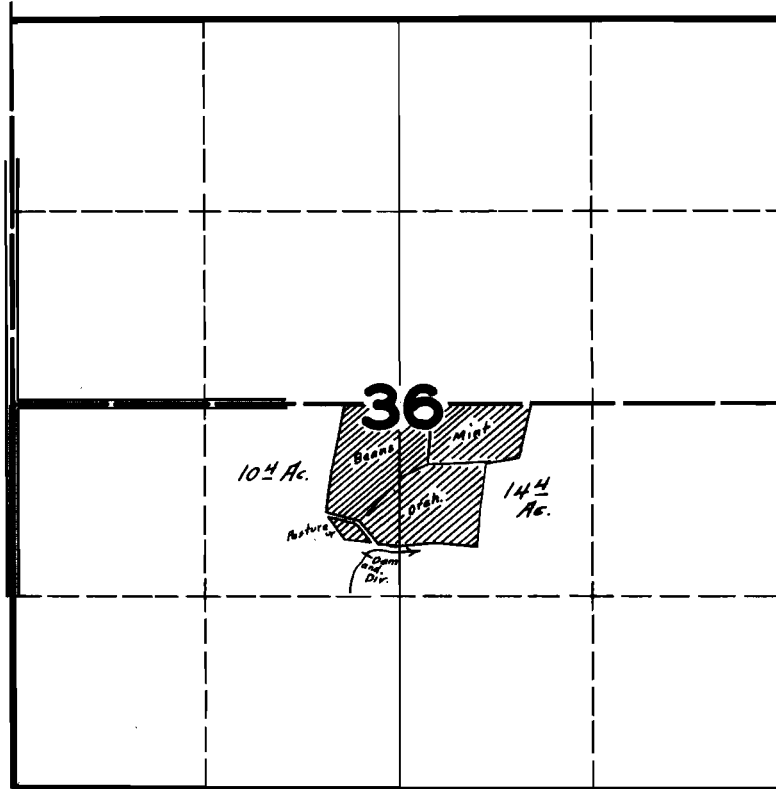

FINAL PROOF SURVEY
UNDER

Application No. 18929 Permit No. 14538

IN NAME OF

H. L. COLVIN

Surveyed MAY 4, 1945, by *[Signature]*