


T.2S. R.1E.W.M.

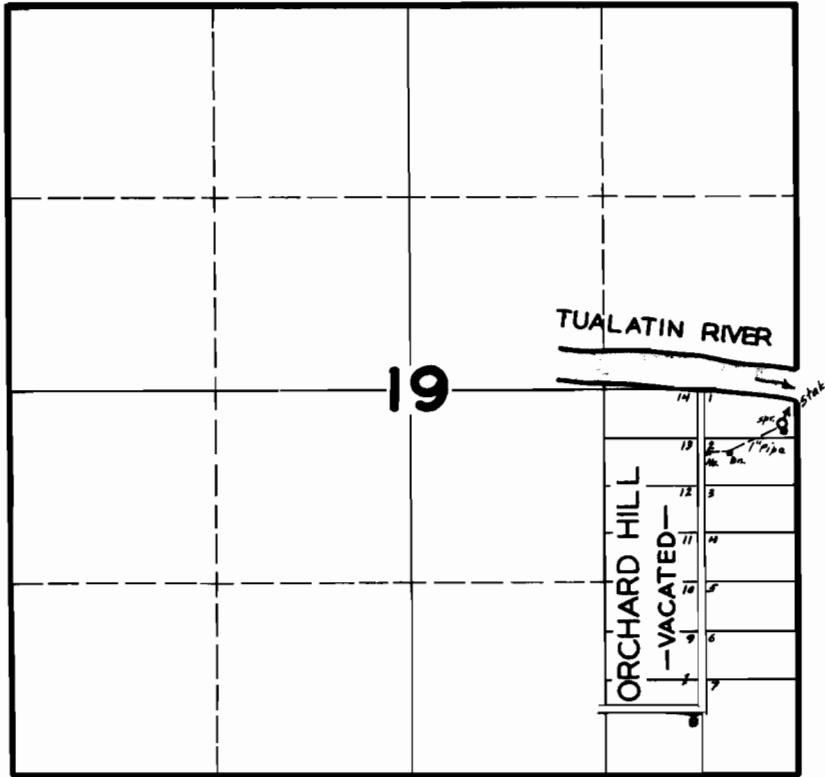

FINAL PROOF SURVEY UNDER

Application No. 18937 ... Permit No. 14543

IN NAME OF

ERNEST WILKE

Surveyed JUNE 11 1945, by