


T.6S. R.IW.W.M.

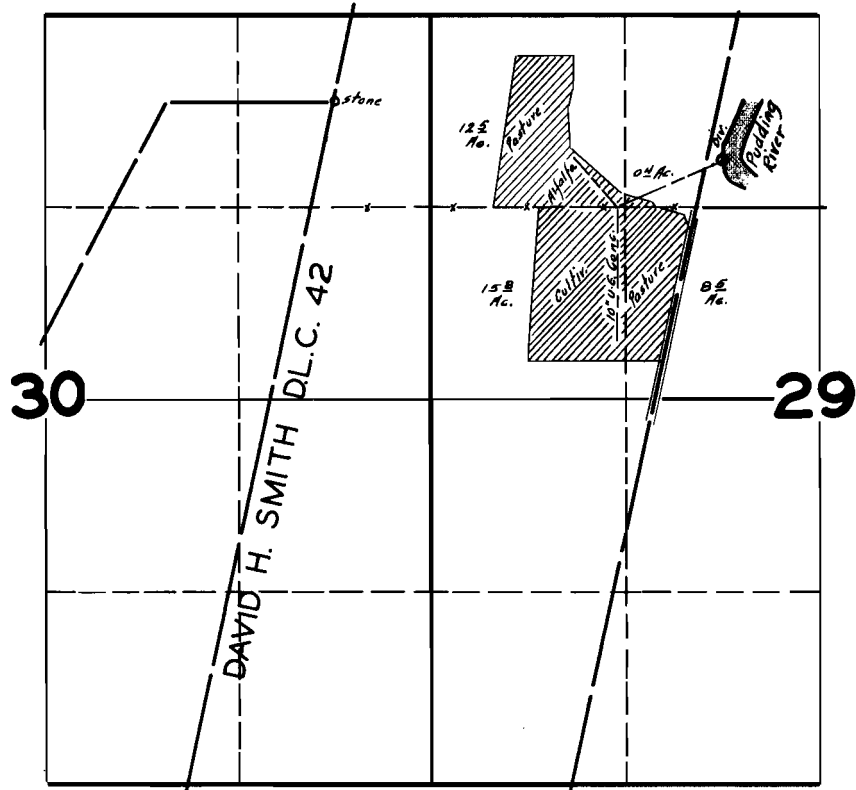

FINAL PROOF SURVEY UNDER

Application No. 19020 Permit No. 14630

IN NAME OF

SAMUEL TORVEND & S.B. TORVEND

Surveyed OCT. 6. 1945, by *James E. Gurnell*