


T.2S.R.3E.W.M.

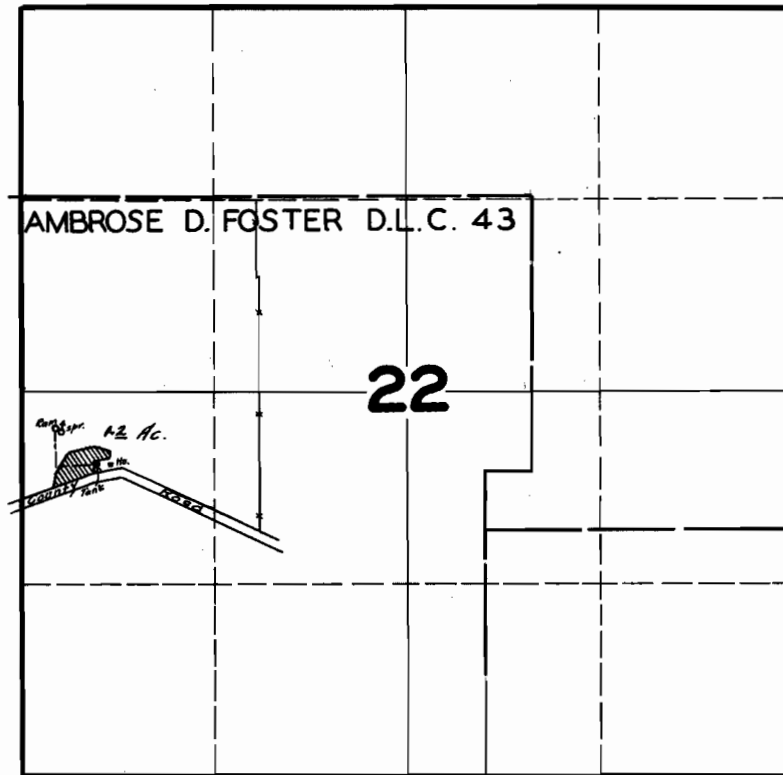

**FINAL PROOF SURVEY
UNDER**

Application No. 19071 Permit No. 14666

IN NAME OF

JOSEPH F. & RUBY A. STRAHM

Surveyed SEPT. 6 1945, by *[Signature]*