


T.2S.R.1W.W.M.

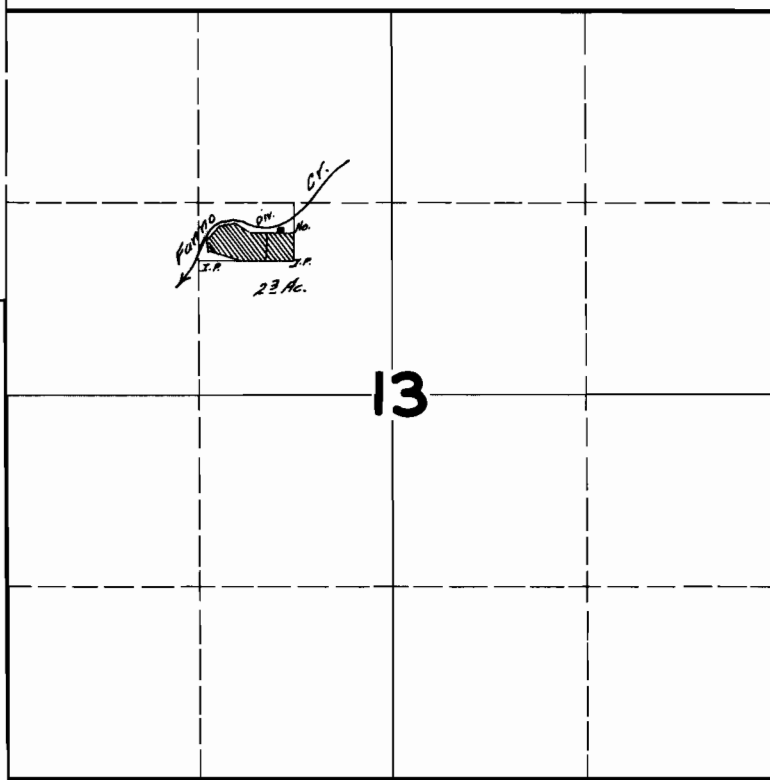

FINAL PROOF SURVEY UNDER

Application No. 19081 Permit No. 14675

IN NAME OF

EDWARD & VIRGINIA BARLETT

Surveyed JUNE 14 1945 by [Signature]